

KANSAS


Pratt

FORM 51 5M PETROL

Section 22 Township 28 Range 12W

Well No. 3 Mawdsley

Company Lion Oil

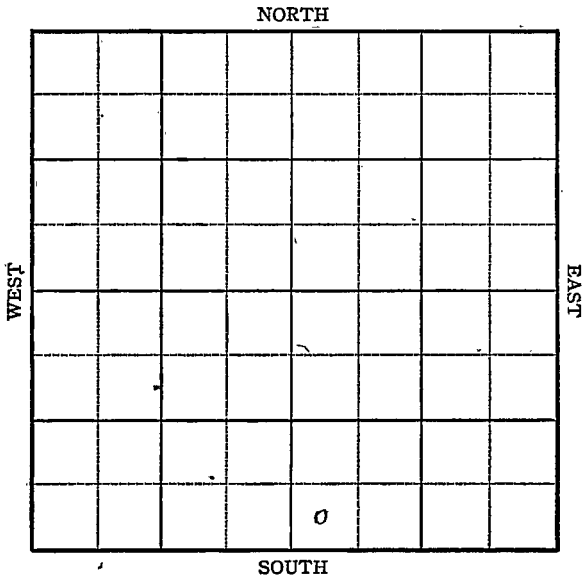

KANSAS Pratt

Sec. 22 Twp. 28 R. 12-W

Well No. #3 Mawdsley Farm


Lion Oil Company

 Ft. from N. Line

330 Ft. from S. Line

 Ft. from E. Line

330 Ft. from W. Line

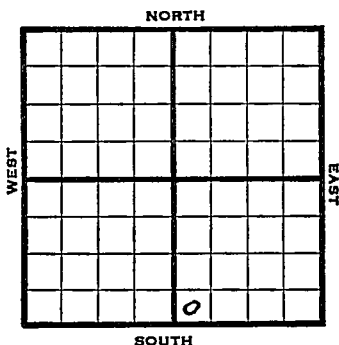

SW SE

1945 Elev. 1868 REPORT

9/26 Location

10/3 9" @ 307

Drlg. 2925

10/10 Drlg. 4172'

10/17 Viola 4310'

Simp Sd. 4409

TD 4480

5" @ 4479 RUST

10/24 90 shots 4419-4435 1000 acid.

Swb. 19-oil-in 3 hrs.

10/31 Simp Sd. 4409

5" @ 4479

TD 4480

90 shots 4419-4435

91 shots 4404-4419

Viola 4310'

2000 acid.

Bomb Pot. 614

Grav. 40.9

COMPLETED

KANSAS

Kansas Pool Name ChitwoodMap No. 54 Sec. 22 Twp. 28 R. 12WWell No. 3 MawdsleyLion Oil

Company

FIRST REPORT

Contractor

SW SE

SECTION PLAT

 Ft. from N. Line330 Ft. from S. Line Ft. from E. Line330 Ft. from W. Line

Pratt County

Location XRig up

Drilling and Remarks:

RECORD

Cased in., ft.Sand Gas Oil Total Depth

PRODUCTION

1st 24 hrs. Nat. 1st 24 hrs. after shot Gas Cu. Ft.Dry Hole Abandoned

Date

SEP 26 1945

19

S. J. LEWIS

Scout

KANSAS

Pool Name ChitwoodMap No. 5-4 Sec. 22 Twp. 28 R. 12WWell No. 3 Mawdsley

Lion Oil

Company

COMPLETED

Contractor

SW SE


E 1/1868
SECTION PLAT

Ft. from N. Line

330 Ft. from S. Line

Ft. from E. Line

330 Ft. from W. Line

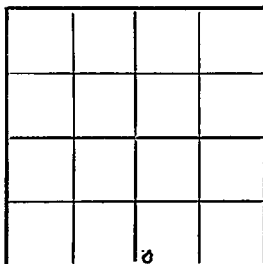

Pratt County

Location

Rig up

Drilling and Remarks:

Drill Log 4409
5" CH 478
90 cks to 4418-35
91 " 4404-19
Vista 4810
2000 acid 6/4
Bone & P. 44
40 E 201

RECORD

Cased _____ in., _____ ft.

Sand _____

Gas _____

Oil _____

Total Depth 4480

PRODUCTION

1st 24 hrs. Nat. _____

1st 24 hrs. after shot _____

Gas _____ Cu. Ft.

Dry Hole _____

Abandoned _____

Date

OCT 31 1945

19

S. J. LEWIS

Scout