


DX 78-1

Section 22 Township 28 Range 42W

Well No. 1 Walkemeyer

Company Huber Corp

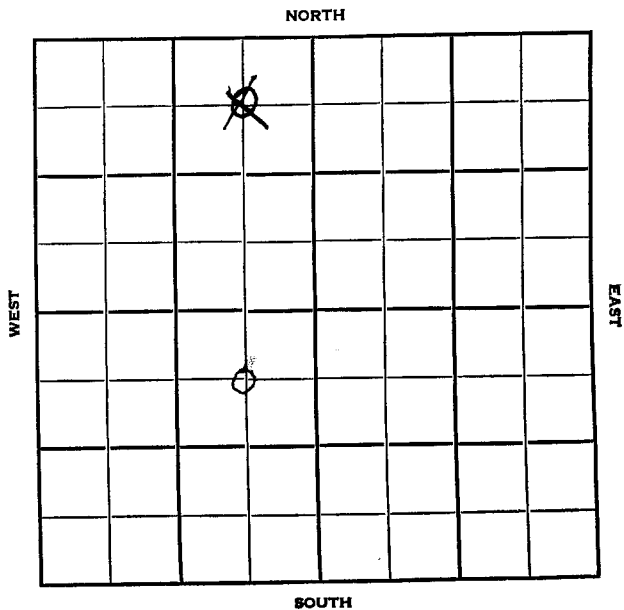

HOT FILE Stanton KANSAS
 SEC. _____ TWP. _____
 WELL NO. 22 28 42W
 COMPANY 1 Walkemeyer FARM
 CONTRACTOR Huber Corp.


Big Chief
 Wildcat

560 _____ Ft. from N. Line

_____ Ft. from S. Line

560 _____ Ft. from E. Line

_____ Ft. from W. Line

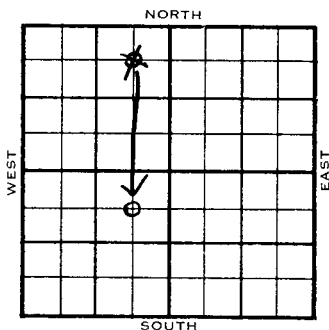

NE ~~SW~~
 NW
 Superior FO

	ELEVATION	REPORT
1954	3520	

7/7 Location

7/21 8" @ 1529
 Blaine 1280 Win 3732 Tow 2782
 Fsh @ 3139

8-18 Spdg 7-10-54
 D&A
 TD 5768
 8" @ 1529
 Blaine 1280 Win. 2732 Tow. 2782
 Top. 3279
 DST 3515-35 open 1 hr. Rec. 305' SW
 615#
 Heeb 3702 Tor. 3728
 DST 3740-70 open 1 hr. Rec. 250' SW
 640#

Lans. 3810
 DST 4314-60 open 1 hr. Rec. 15' mud
 375#
 Cherokee 4576
 Schlumberger Tops: Top. 3268
 Heeb 3692 Tor. 3718 Doug 3770
 Lans. 3804 Marm 4102 Cherokee 4520
 Morrow 5122 St. Gen. 5558 St. Louis 576
 DST 5550-70 open 1 hr. Rec. 1020' SW
 DST 5562-5650 open 1 hr. Rec. 50' mud
 270#


1954
8-18

Information brought forward
TD 5768

DST 3948-4014 open 1 hr. Rec. 5' mud
1615#
D&A

ABANDONED

County **Stanton** State **Kansas**
 Sec. **22** (Blk. Twp.) **28** (Sur. Rge.) **42W** Map No.
 Operator **Huber Corp.**
 Well No. **1** Farm **Walkemeyer**
 Elev. Location **C NE NW**

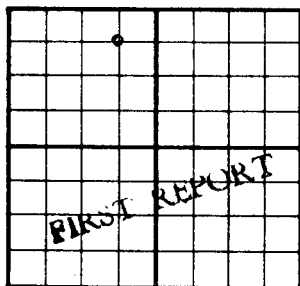

660 Ft. From **N** Line **NW**
660 Ft. From **E** Line Quarter
 1st. Report **JUL 7 1954**
 Completion
 Remarks **Superior farmout**
Big Chief - Contr.
 Spudding Date

Drlg. Data

Wildcat

Kansas

Map No. _____ Sec. 22 Twp. 28 R. 42WWell No. 1 Walkemeyer

Huber Corp. _____ Company

CORRECTION

Contractor

C NE SW

SECTION PLAT

	0		

660 Ft. from N. Line Ft. from S. Line660 Ft. from E. Line Ft. from W. Line

Stanton County

Location _____

Rig up _____

Drilling and Remarks:

Reported

C NE NW

RECORD

Cased _____ in., _____ ft.

Sand _____

Gas _____

Oil _____

Total Depth _____

PRODUCTION

1st 24 hrs. Nat. _____

1st 24 hrs. after shot _____

Gas _____ Cu. Ft.

Dry Hole _____

Abandoned _____

Date

JUL 21 1954

19

J. G. McGEHEE Scout

County Stanton State KansasSec. 22 (Blk. 28) (Sur. 4 2W) Map No. Operator Huber Corp.Well No. 1 Farm WalkemeyerElev. 3520 Location C NE SW660 Ft. From N Line SW660 Ft. From E Line Quarter1st. Report Completion AUG 18 1954Remarks WildcatBig Chief - Contr.Spudding Date 7-10-54Drlg. Data D & A TD 57688" @ 1529 Blaine 1280 Win. 2732Tow. 2782 Top. 3279 DST 3515-35open 1 hr. Rec. 305' sw 615#Heeb. 3702 Tor. 3728 DST 3740-70open 1 hr. Rec. 250' sw 640#Lans. 3810 DST 4314-60 open 1 hr.Rec. 15' mud 375# Cherokee 4576SCHLUMBERGER TOPSTop. 3268 Heeb. 3692 Tor. 3718Doug. 3770 Lans. 3804 Marm. 4102Cherokee 4520 Morrow 5122 St. Gen. 5558St. Louis 5760 DST 5550-70 open 1 hr.Rec. 1020' sw 855# DST 5562-5650open 1 hr. Rec. 50' mud 270#

FABEN GILSTRAP

Drig. Data

Misc.

TD 5768

DST 3948-4014

open,

hr.

Rec. 5' mud

1615#

Tracings

Land Well Head

Land Small Head

Secret Cards

