

KANSAS


FORM 51 IOM 12-46 PETROL

Grant

Section 23 Township 28 Range 38-W

Well No. #1 Sturgeon D"

Company Stanolind

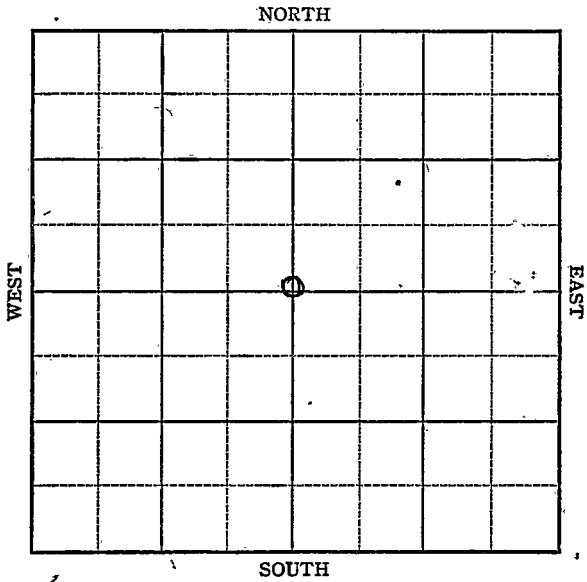

KANSAS

Grant

Sec. 23 Twp. 28 R. 38-W

Well No. #1 Sturgeon "D" Farm

Stanolind Company
Hugoton Pool


2640 Ft. from N. Line

_____ Ft. from S. Line

2640 Ft. from E. Line

_____ Ft. from W. Line

C. Sec.

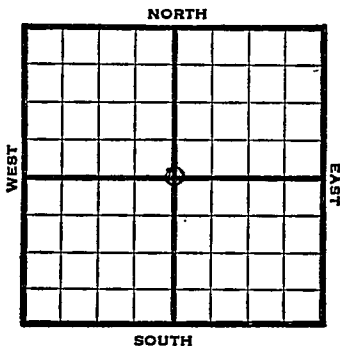

1947 Elev. 3068'

REPORT

2/19 8" @ 611
Drlg 2388'

2/26 TD 2496'

3/12 5" @ 2515
Perf
40,000 Acid
7,145,000 Gas
405# R Pr
TD 2555'

COMPI

Kansas

KANSAS Hugoton Pool

Map No. _____ Sec. 23 Twp. 28 R. 38WWell No. 1 Sturgeon "D"

Stanolind _____ Company

FIRST REPORT _____ Contractor

C Sec.


SECTION PLAT

2640 Ft. from N. Line

_____ Ft. from S. Line

2640 Ft. from E. Line

_____ Ft. from W. Line

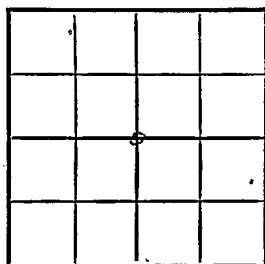

Grant County

Location _____

Rig up _____

Drilling and Remarks:

8" @ 611

drlg. 2388

RECORD

Cased _____ in., _____ ft.

Sand _____

Gas _____

Oil _____

Total Depth _____

PRODUCTION

1st 24 hrs. Nat. _____

1st 24 hrs. after shot _____

Gas _____ Cu. Ft.

Dry Hole _____

Abandoned _____

Date

FEB 1 9 1947 19

S. J. LEWIS Scout

Map No. _____ Sec. 23 Twp. 28 R. 38WWell No. 1 Sturgeon "D"

_____ Stanolind _____ Company

_____ COMPLETE _____ Contractor


C Sec.

E13068
SECTION FLAT2640 Ft. from N. Line

_____ Ft. from S. Line

2640 Ft. from E. Line

_____ Ft. from W. Line

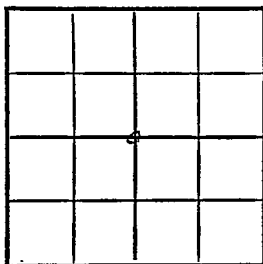

Grant. County

Location _____

Rig up _____

Drilling and Remarks:

*5' @ 25' 15"**Perf.**40000 cu ft**7,145,000 Gall**445* R/A*

RECORD

Cased _____ in., _____ ft.

Sand _____

Gas _____

Oil _____

Total Depth 2355

PRODUCTION

1st 24 hrs. Nat. _____

1st 24 hrs. after shot _____

Gas _____ Cu. Ft.

Dry Hole _____

Abandoned _____

Date

MAR 1 2 1947 19S. J. LEWIS Scout