

KANSAS


FORM 51 SM 11-44 PETROL

Grant county

Section 23 Township 28 Range 36W

Well No. #1, Gano "B"

Company Columbian Fuel

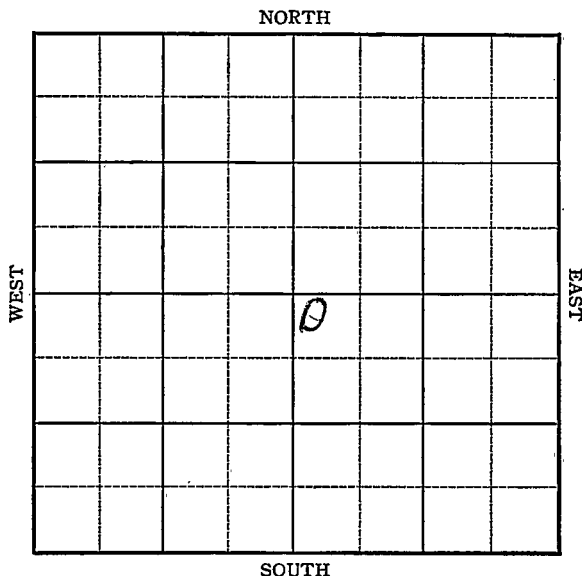

KANSAS

Grant County



Sec. 23 Twp. 28 R. 36W

Well No. #1 Gano "B" Farm

Columbian Fuel Company

Hugoton


100 Ft. from N. Line

 Ft. from S. Line

 Ft. from E. Line

100 Ft. from W. Line

NW SE

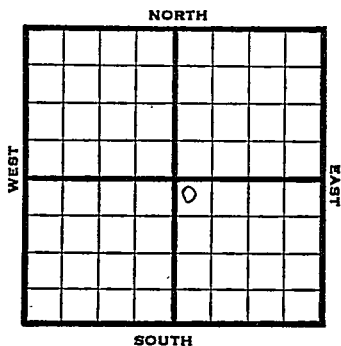

1946 Elev 3069' REPORT

4/17 RUR
4/23 10" @ 687
2083 fsg
5/1 TD 2511
7" @ 2500 RUST
5/7 Drlg 2690'
5/14 TD 2719
227' of 5" Perf liner @ 2719'
5/21 14000 acid
5/29 7" @ 2500'
227' of 5" Perf liner @ 2719
TD 2719'
14000 acid
16,272,000 Gas
402# R. Pr.

COMPLETED

KANSASKansas Pool Name HugotonMap No. _____ Sec. 23 Twp. 28 R. 36WWell No. 1 Gano "B"

Columbian Fuel _____ Company

FIRST REPORT

Contractor _____

NW SE

SECTION PLAT100 Ft. from N. Line

_____ Ft. from S. Line

_____ Ft. from E. Line

100 Ft. from W. Line

		o	

Grant County

Location _____

Rig up _____

Drilling and Remarks: ✓

R U R

RECORD

Cased _____ in., _____ ft.

Sand _____

Gas _____

Oil _____

Total Depth _____

PRODUCTION

1st 24 hrs. Nat. _____

1st 24 hrs. after shot _____

Gas _____ Cu. Ft.

Dry Hole _____

Abandoned _____

Date

APR 17 1946 19S. J. LEWIS Scout

~~KANSAS~~ ^{Kans.} Pool Name Hugoton Pool
 Map No. _____ Sec. 23 Twp. 28 R. 36W
 Well No. 1 Gano "B"

Columbian Fuel Company

COMPLETED

Contractor

E13069

NW SE


SECTION PLAT

100 Ft. from N. Line

_____ Ft. from S. Line

_____ Ft. from E. Line

100 Ft. from W. Line

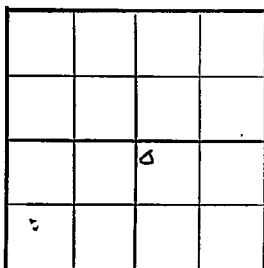

Grant County

Location _____

Rig up _____

Drilling and Remarks:

7" @ 2500

227' of 5" Perf. Liner

@ 2715

14000000

16, 272, 000 lbs

402 # R/P

RECORD

Cased _____ in., _____ ft.

Sand _____

Gas _____

Oil _____

Total Depth 2219

PRODUCTION

1st 24 hrs. Nat. _____

1st 24 hrs. after shot _____

Gas _____ Cu. Ft.

Dry Hole _____

Abandoned _____

Date

MAY 29 1946

S. J. LEWIS

Scout