

Section 23 Township 28 Range 32WWell No. #1 ReimeltCompany Skelly

NORTH

WEST

EAST

			0				

SOUTH

Haskell

KANSAS

Sec. 23 Twp. 28 R. 32W ✓

Well No. #1 Reimelt Farm

Skelly Company

Contractor

Hugoton

330 Ft. from N. Line


 Ft. from S. Line

330

 Ft. from E. Line

 Ft. from W. Line

NE NESW

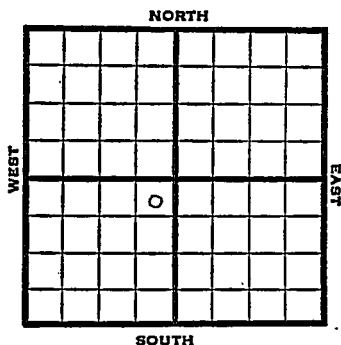

1951 Elev. 2912' REPORT

10/10 Spud 10-5-51
10" @ 653'
12/12 Spud 10-5-51
Gas Well Td 2772
10" @ 653
Her. 2660 Kri. 2690
Win. 2758 TD 2762
7" @ 2761 DD 2772 5000 A
192/ 2710-42 2000 A
24000 A 6000 A
Comp. 698,000 gas 372#

COMPLETED

County Haskell State Kansas

Sec. 23 (Blk. 28) (Sur. 32W) Map No. _____

Operator Skelly

Well No. **1** Farm **Reimelt**

Elev.	Location	NE NE SW

FIRST REPORT

330 Ft. From N Line SW

330 Ft. From E Line Quarter

1st. Report **OCT 10 1951**

Completion _____

Remarks

Spudding Date **10-5-51**

Drlg. Data Hugoton

10" @ 653


J. E. TYRA

County Haskell State Kansas
 Sec. 23 (Blk.) 28 (Sur.) 32W Map No.

Operator Skelly

Well No. 1 Farm Reimelt

Elev. 2912 Location NE NE SW

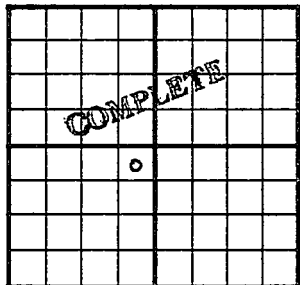

330 Ft. From N Line SW

330 Ft. From E Line Quarter

1st. Report

Completion DEC 1 2 1951

Remarks Hugoton Pool

Spudding Date 10-5-51

Drlg. Data Gas well TD 2772

10" @ 653 Her. 2660 Kri. 2690

Win. 2758 TD 2762 7" @ 2761 DD 2772

5000 A 192/ 2710-42 2000 A

24000 A 6000 A Comp. 698,000 gas

372#

J. E. TYRA