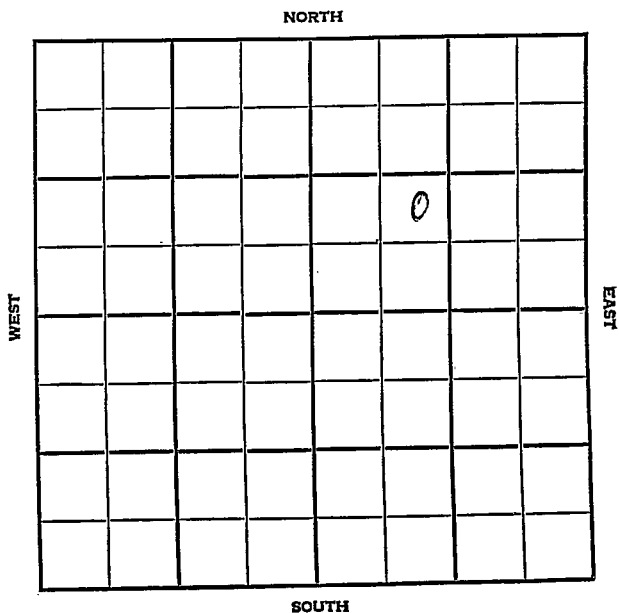


KANSAS

Section 23 Township 28 Range 21WWell No. #1 KarnsCompany Graham-Michaelis & Skelly

County Ford Elev. 21W
 Sec. 23 Twp. 28 Rgs. 21W
 Company Graham-Michaelis & Skelly
 Farm Name Karns No. 1

TOPS	DEPTH	LOG	DATUM
Anh.			
Tr.			
H.			
Tr.			
Dg.			
Bl.			
L.			
K.C.			
B.K.C.			
Ce.			
C.			
M.			
M.			
K.			
Mz.			
Mq.			
V.			
S.			
S.			
A.			
R.			
Pe.			
G.			
T.D.			

Loc. in Sec. NE SW NE

Geol. _____

Contr. _____

Co. Tools _____

Pool _____

Pleasant Valley

So. _____

	00	31	56
		2	

FIRST REPORT

Date Comm. spd. 10-25-56 Mag. (FO)
8" @ 244, Drlg. 2830

300

100











County Ford Elev. 2366
 Sec. 23 Twp. 28 Rge. 21W
 Company Graham-Michaelis & Skelly
 Farm Name Karns No. 1

TOPS	DEPTH	LOG	DATUM	Loc. in Sec.
Anh.				NE SW NE
Tr.				
H.				
Tr.				
Dg.				
Bl.	4329			
L.	4341			
K.C.				Geol. -
B.K.C.				Contr.
Ce.				Co. Tools
C.				
M.	5000			Pool
M.				Pleasant Valley
K.				So.
Mz.				DEC 5 '56
Mo.				o
V.				
S.				
S.				
A.				
R.				
PE.				
G.				
TD.	5100			COMPLETE

Date Comm. spd. 10-25-56 Mag. (FO)
 8" @ 244, Drlg. 2830 NOV 7 '56

M 4747 NOV 13 '56 DST 5020-60
 1hr G/2" ga 4,450 MCF res
 10' GCM E O spotted Md + 90' 50 E 6 CM
 + 160' OC E 9554 Md + 20' Wt NOV 28 '56
 1670/20" 5 1/2 5100 NOV 21 '56 V
 CO 5080 -80/5040-60 ga 6,100
 MCF M2 ga 13 Mill C.F.L
 CP 950 # DEC 5 '56 162 FLOW

14,380 MCFG 2" T69
CP 200# S. I. 3 1/2 hrs
CP 1600#