Pratt


DX 78-1

KANSAS

Section 23 (28) Township 28 Range 12W

Well No. #3 Water Supply Well

Company Chitwood Unit (Monsanto Exper.)

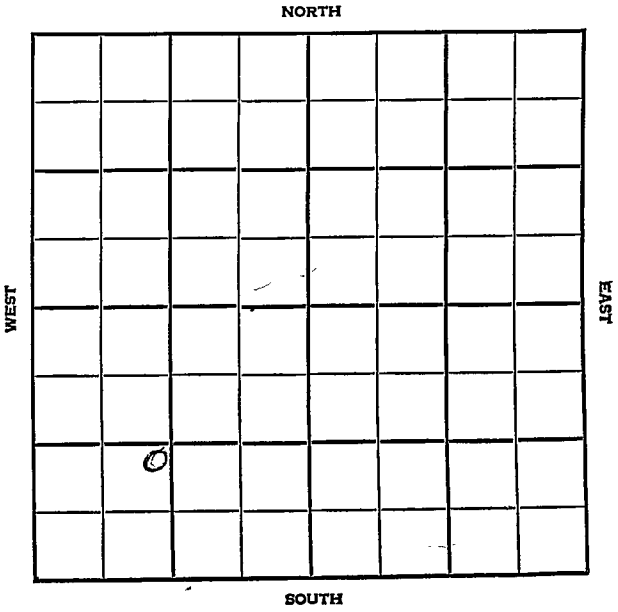

FORM 513 SUNRAY

County Pratt Elev.

Sec. 28 Twp. 28 Rge. 12W

Company Chitwood Unit

Farm Name Water Supply Well No. 3

| TOPS | DEPTH | LOG | DATUM |
|---|---|---|---|
| Anh. | | | |
| T.P. | | | |
| H. | | | |
| Tr. | | | |
| Dg. | | | |
| Bl. | | | |
| L. | | | |
| K.C. | | | |
| B.K.C. | | | |
| Ce. | | | |
| C. | | | |
| M. | | | |
| M. | | | |
| K. | | | |
| Mz. | | | |
| Mo. | | | |
| V. | | | |
| S. | | | |
| S. | | | |
| A | | | |
| R. | | | |
| P€. | | | |
| G. | | | |
| T.D. | | | |

Loc. in Sec. 1090' E. & 495' No of SW Corner of Sec.

Geol.

Contr. Garvey Drlg.

Pool




Date Comm. spd. 10-18-56

17½" hole to 326, 13" @ 322 w/350, Drlg. 1845

Co.

Lse.

No.

Sec.

T.

R.

# CORRECTION

FORM 513 SUNRAY

County Pratt Elev.

Sec. ~~28~~ 23 Twp. 28 Rge. 12W

Company Chitwood Unit (Monsanto Oper.

FarmName Water Supply Well No. 3

| TOPS | DEPTH | LOG | DATUM |
|---|---|---|---|
| Anh. | | | |
| Tp. | | | |
| H. | | | |
| Tr. | | | |
| Dg. | | | |
| Bl. | | | |
| L. | | | |
| K.C. | | | |
| B.K.C. | | | |
| Ce. | | | |
| C. | | | |
| M. | | | |
| M. | | | |
| K. | | | |
| Mz. | | | |
| Mo. | | | |
| V. | | | |
| S. | | | |
| S. | | | |
| A | | | |
| R. | | | |
| Pe. | | | |
| G. | | | |
| T.D. | 3500 | | |

Loc. in Sec. 1090' E. & 495' No of SW Corner of Sec.

Geol.

Contr. Garvey Drlg.

Pool

COMPLETE NOV 29 '56

Date Comm. spd. 10-18-56

17½" hole to 326. 13" @ 322 w/350, Drlg. 1845 OCT 31 '56

7¾" hole to 3500 NOV 7 '56

NOV 13 '56 NOV 21 '56

9 5/8 3416/300 NOV 23 '56

P. 4654 BW 24 hrs.

complete water supply well

Co. Lse. No. Sec. T. R.