

KANSAS


FORM 51 5M 1-42 PETROL

Pratt

Section 23 Township 28 Range 12-W

Well No. #2 Chitwood


Company Lion Oil Ref.

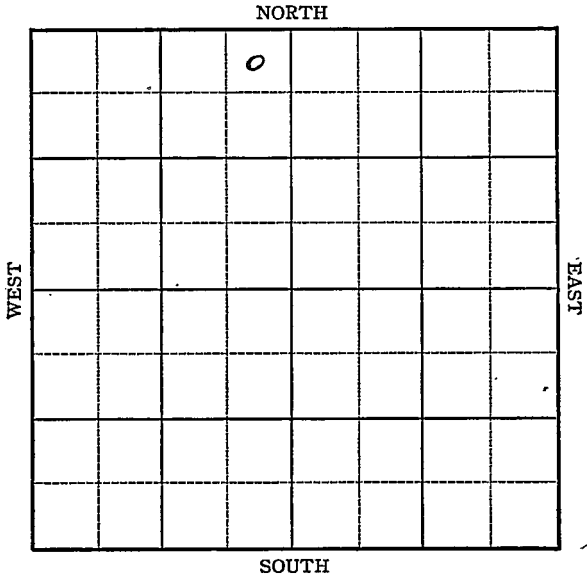

Sec. 23 Twp. 28 R. 12-W

Well No. #2 Chitwood Farm  
Lion Oil Ref. Company

NORTH

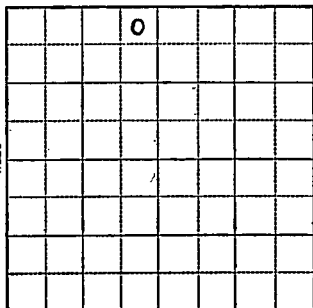

330 Ft. from N. Line

\_\_\_\_\_ Ft. from S. Line

330 Ft. from E. Line

\_\_\_\_\_ Ft. from W. Line

*Elev. 1878*

SOUTH

1943

R E P O R T

- 9/29 Rotary
- 10/6 10" @ 303'  
WOC.
- 10/13 Drlg. 2930'
- 10/20 Lans 3706  
Drlg. 4000 SSO
- 10/27 Viola 4278  
Simp 4377  
T.D. 4411 SO & Gas
- 11/3 Arb 4485-98 T.D.  
7" @ 4485  
Rust
- 11/10 36 shots 4397-4407  
1000 acid flow 34 oil per hr.
- 11/17 Viola 4278  
Simp 4377  
Arb 4485  
5" @ 4485  
Perf. Simpson  
1000 acid  
Bomb Pot 2868  
T.D. 4498'  
Gravity 41.4

**COMPLETED**

KANSAS

Map No. 54 Sec. 23 Twp. 28 R. 12W

Well No. 2 Chitwood

Lion Oil Ref. Company

FIRST REPORT

Contractor

NE NW

SECTION PLAT

330 Ft. from N. Line

\_\_\_\_\_ Ft. from S. Line

330 Ft. from E. Line

\_\_\_\_\_ Ft. from W. Line

		o	

Chitwood Pool

Location \_\_\_\_\_

Rig up \_\_\_\_\_

Drilling and Remarks:

Rotary

RECORD

Cased \_\_\_\_\_ in., \_\_\_\_\_ ft.

Sand \_\_\_\_\_

Gas \_\_\_\_\_

Oil \_\_\_\_\_

Total Depth \_\_\_\_\_

PRODUCTION

1st 24 hrs. Nat. \_\_\_\_\_

1st 24 hrs. after shot \_\_\_\_\_

Gas \_\_\_\_\_ Cu. Ft.

Dry Hole \_\_\_\_\_

Abandoned \_\_\_\_\_

Date

SEP 29 1943 19

S. J. LEWIS Scout

Map No. 54 Sec. 23 Twp. 28 R. 12W

Well No. 2 Chitwood

Lion Oil Ref. Company

COMPLETED Contractor

NE NW

SECTION PLAT

		o	

330 Ft. from N. Line

\_\_\_\_\_ Ft. from S. Line

330 Ft. from E. Line

\_\_\_\_\_ Ft. from W. Line

Chitwood Pool

Location \_\_\_\_\_

Rig up \_\_\_\_\_

Drilling and Remarks:

*Vista 4278*  
*Simp 4377*  
*Co 4485*  
*5" @ 4485*  
*Prof Simpson*  
*1600 feet*  
*Bon & Pat 2868*

RECORD

Cased \_\_\_\_\_ in., \_\_\_\_\_ ft.

Sand \_\_\_\_\_

Gas \_\_\_\_\_

Oil \_\_\_\_\_

Total Depth 4485

PRODUCTION

1st 24 hrs. Nat. \_\_\_\_\_

1st 24 hrs. after shot \_\_\_\_\_

Gas \_\_\_\_\_ Cu. Ft.

Dry Hole \_\_\_\_\_

Abandoned \_\_\_\_\_

Date

*4 17/82*

NOV 17 1943 19

S. J. LEWIS Scout