

KANSAS

Pratt

FORM 51 5M PETROL

Section 23 Township 28 Range 12-WWell No. #3 ChitwoodCompany Lion Oil Ref.

	0						

NORTH

WEST

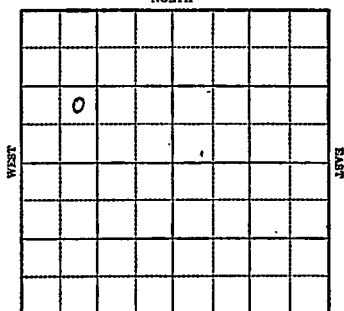
EAST

SOUTH

Sec. 23 Twp. 28 R. 12-WWell No. #3 Chitwood FarmLion Oil Ref. Company

NORTH

SOUTH

 Ft. from N. Line990 Ft. from S. Line Ft. from E. Line990 Ft. from W. LineElev. 1866

1943

R E P O R T

10/13 Location .

10/20 8" @ 305'
Drlg. 2000'

10/27 Drlg. 3700'

11/3 Land 3705
Viola 4268
Simp Soly Dolo 4370
SO

Coring 4377

11/10 Arb 4470-74 T.D.

5" @ 4470 Rust

11/17 Arb 4474-81
Viola 4275

Simp 4370

Arb. 4477

TD 4487

24 shots 4280-88

2000 acid; 22 M Gas

11/24 5" @ 4470'

Simp 4370'

Arb 4477

92 Shots 4389-4405

Bomb. Pot. 3932

Max 3000

Grav. 41°

TD 4481'

COMPLETED

Map No. KANSAS Sec. 23- Twp. 28 R. 12WWell No. 3 ChitwoodLion Oil Ref.

Company

FIRST REPORT

Contractor

NE SW NW

SECTION PLAT

 Ft. from N. Line990 Ft. from S. Line Ft. from E. Line990 Ft. from W. Line

6			

Chitwood PoolLocation XRig up

Drilling and Remarks:

RECORD

Cased in., ft.Sand Gas Oil Total Depth

PRODUCTION

1st 24 hrs. Nat. 1st 24 hrs. after shot Gas Cu. Ft.Dry Hole Abandoned

Date

OCT 13 1943

19

S. J. LEWIS

Scout

KANSAS Pratt

Map No. 54 Sec. 23 Twp. 28 R. 12WWell No. 3 Chitwood

Lion Oil Ref.

Company

COMPLETED

Contractor

NE SW NW

SECTION PLAT

o			

Ft. from N. Line

990

Ft. from S. Line

Ft. from E. Line

990

Ft. from W. Line

Chitwood Pool

Location

Rig up

Drilling and Remarks:

*Shut 4370**CE 4477**5" @ 4470**925 hrs to 4389-4405**Born & Pa 3932**Max 3000*

RECORD

Cased _____ in., _____ ft.

Sand _____

Gas _____

Oil _____

Total Depth 4481

PRODUCTION

1st 24 hrs. Nat. _____

1st 24 hrs. after shot _____

Gas _____ Cu. Ft.

Dry Hole _____

Abandoned _____

Date

4/2/44

NOV 24 1943

19

S. J. LEWIS

Scout