

KANSAS

Pratt

FORM 51 5M 1-42 PETROL

Section 23 Township 28 Range 12-W

Well No. #4 Chitwood

Company Lion Oil Ref.

	0						

NORTH


WEST

EAST

SOUTH

KANSAS

Pratt

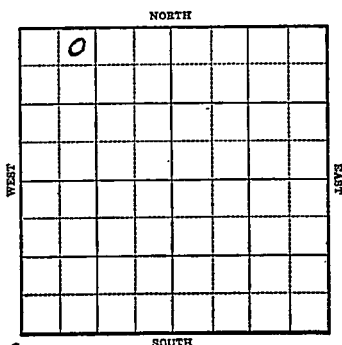Sec. 23 Twp. 28 R. 12-WWell No. #4 Chitwood FarmLion Oil Ref. Company330 Ft. from N. Line Ft. from S. Line Ft. from E. Line990 Ft. from W. LineElev. 1866

R E P O R T

1943

11/10 Rotary
 11/17 Drlg. 1150'
 12/1 Drlg 3410'
 12/8 Lans 3693
 TD 3719
 5" @ 3719
 RUST

12-15 " "

12/22 Drlg. 3736'
 12/29 TD 3740-1500 acid
 Swb 5 oil per hr 10% water
 Drlg 3745

1944

1-5 TD 3875 swb 5 oil & 10% water per hr.

1-12 Drlg 3880'

1/19 Viola 256
 Drlg. 4286

1/26 Simp sd 4356 SO
 Arb 4452-57 TD
 5" @ 4454

2/2 Rust
 TD 4460
 4000 acid
 Flow 18 oil per hr.

2/8 4000 acid
 Flow 30 oil PH 4 hrs.

OVER

1944
2/16

5" @ 4454
Arb 4452
TD 4460
7000 acid
Bonb Pot. 2609
Gravity 41

COMPLETED

~~KANSAS~~Map No. 57 Sec. 23 Twp. 28 R. 12WWell No. 4 ChitwoodLion Oil Ref. CompanyFIRST REPORT Contractor

NE NW NW

SECTION PLAT

330 Ft. from N. Line Ft. from S. Line Ft. from E. Line990 Ft. from W. Line

o			

Chitwood PoolLocation Rig up

Drilling and Remarks:

Rotary

RECORD


Cased in., ft.Sand Gas Oil Total Depth

PRODUCTION

1st 24 hrs. Nat. 1st 24 hrs. after shot Gas Cu. Ft.Dry Hole Abandoned

Date

NOV 10 1943 19 S. J. LEWIS Scout

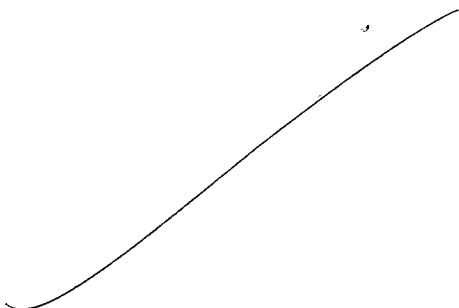

Misc. Small Map	<i>Qua</i>
Cards	<i>Madge</i>
Tracing	<i>NOEL</i>
France Map	<i>[initials]</i>
Scarborough Map	<i>[initials]</i>
Pierce Map	<i>[initials]</i>
Geological Dept.	<i>[initials]</i>
Pierce Plat Book	<i>[initials]</i>

KANSAS

Map No. 54 Sec. 23 Twp. 28 R. 12WWell No. 4 ChitwoodLion Oil Ref.

Company

COMPLETED

Contractor

NE NW NW

SECTION PLAT

on

0			

330

Ft. from N. Line

Ft. from S. Line

Ft. from E. Line

990

Ft. from W. Line

Chitwood Pool

Location

Rig up

Drilling and Remarks:

*Cor 4452.**5" C 4454**7000 acid**Born X P 2609**412/3*

RECORD

Cased _____ in., _____ ft.

Sand _____

Gas _____

Oil _____

Total Depth 4460

PRODUCTION

1st 24 hrs. Nat. _____

1st 24 hrs. after shot _____

Gas _____ Cu. Ft.

Dry Hole _____

Abandoned _____

Date

FEB 16 1944 19

S. J. LEWIS

Scout

17

25

FROM :

JOHN L. L. L.









- | | |
|------------------|--------------|
| Misc. Small Maps | <i>Ona</i> |
| Cards | <i>Madge</i> |
| Tracing | <i>DE</i> |
| France Map | <i>✓</i> |
| Scarborough Map | <i>✓</i> |
| Moody Map | <i>✓</i> |
| Geological Dept. | |
| Moody Plat Book | |