

KANSAS

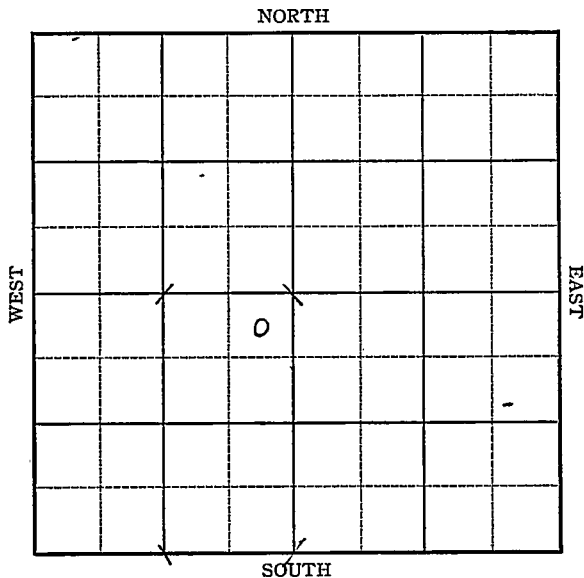
FORM 51 5M 1-42 PETROL

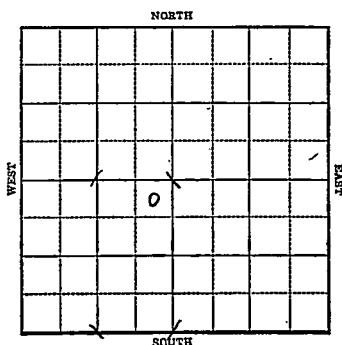
Pratt

Section 23 Township 28 Range 12-W

Well No. #5 Chitwood
~~#1 Earl~~

Company Lion Oil Ref.



Sec. 23 Twp. 28 R. 12-WWell No. ~~#1 Earl~~ #5 Chitwood FarmLion Oil Ref. Company330 Ft. from N. Line Ft. from S. Line330 Ft. from E. Line Ft. from W. LineElev. 1868

1943

R E P O R T

9/22 8" @ 314'
Drlg. 500'
9/29 Drlg. 3000'
10/6 Lans 3713 SO
Drlg. 4220'
10/13 Viola 4290
Coring 4422
Simp Dolo 4385
10/20 No report.
10/27 Viola 4290
5" @ 4453
Simp' 4385
11-shots 4413-16
500 acid
Bomb Pot 1414
T.D. 44558
Gravity 40

COMPLETED

KANSAS

Map No. 54 Sec. 23 Twp. 28 R. 12WWell No. 1 EarlLion Oil Ref. Company

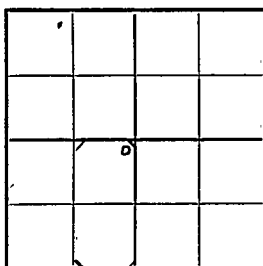
FIRST REPORT

Contractor

NE SW

330 Ft. from N. Line Ft. from S. Line330 Ft. from E. Line Ft. from W. Line

SECTION PLAT

WildcatLocation Rig up

Drilling and Remarks:

8" - 314500 Drill

RECORD

Cased in., ft.Sand Gas Oil Total Depth

PRODUCTION

1st 24 hrs. Nat. 1st 24 hrs. after shot Gas Cu. Ft.Dry Hole Abandoned

Date

SEP 22 1943

19

S. J. LEWIS

Scout

KANSAS

Map No. 34 Sec. 23 Twp. 28 R. 12WWell No. 5 Chitwood

Lion Oil Ref.

Company

CORRECTION

Contractor

NE SW

SECTION PLAT

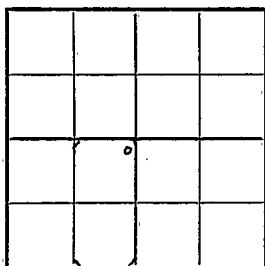
330 Ft. from N. Line

Ft. from S. Line

330 Ft. from E. Line

Ft. from W. Line

Chitwood Pool



Location

Rig up

Drilling and Remarks:

Change from
#1 Earl

RECORD

Cased _____ in., _____ ft.

Sand _____

Gas _____

Oil _____

Total Depth _____

PRODUCTION

1st 24 hrs. Nat. _____

1st 24 hrs. after shot _____

Gas _____ Cu. Ft.

Dry Hole _____

Abandoned _____

Date

OCT 26 19

S. J. LEWIS Scout

KANSASMap No. 37 Sec. 23 Twp. 28 R. 12WWell No. 5 ChitwoodLion Oil Ref.

Company

COMPLETED

Contractor

NE SW

SECTION PLAT

330

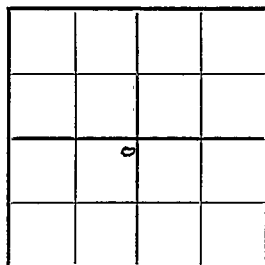
Ft. from N. Line

Ft. from S. Line

330

Ft. from E. Line

Ft. from W. Line

Wildcat

Location

RECORD

Cased _____ in., _____ ft.

Sand _____

Gas _____

Oil _____

Total Depth 4450

Rig up

Drilling and Remarks:

Viola 42905-1 104459Imp. 438511 shots 4413-16500 acidBorn & Pa 141440° Se

PRODUCTION

1st 24 hrs. Nat. _____

1st 24 hrs. after shot _____

Gas _____ Cu. Ft.

Dry Hole _____

Abandoned _____

Date

OCT 27 1943 19

S. J. LEWIS

Scout