

KANSAS


Pratt

FORM 51 5M PETROL

Section 23 Township 28 Range 12W

Well No. 15 Chitwood twin #4

Company Lion Oil

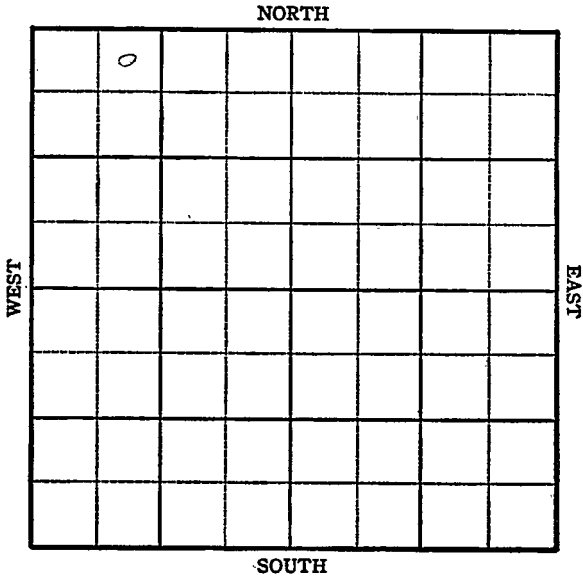

Sec. 23 Twp. 28 R. 12-W

Well No. #15 Chitwood-twin #4 Farm


Lion Oil Company

390 Ft. from N. Line

\_\_\_\_\_ Ft. from S. Line

\_\_\_\_\_ Ft. from E. Line

990 Ft. from W. Line

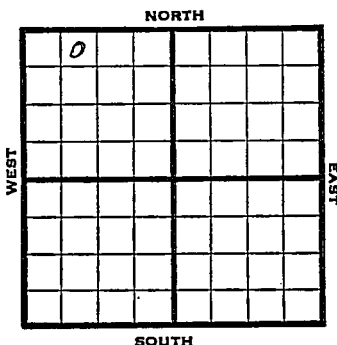

NE NW NW

1945 <sup>1067</sup> Elev. 1879 REPORT

00/10 Location

10/17

"

10/24

"

10/31

"

11/7

8" @ 320

Drlg. 1855'

11/14

Drlg. 3469'

11/21

Lans 3695

TD 3700

7" @ 3699 RUST

11/28

TD 3744

1000 acid.

Swab 3 oil per hr.

12/5

" " " "

12/12

Pump 40 oil plus 150 W a day

12/19

Lans 3695

7" @ 3699

1000 acid.

TD 3744

Pump 40 Pot.

Grav. 40.9

**COMPLETED**

KANSAS Pool Name ChitwoodMap No. 54 Sec. 23 Twp. 28 R. 12WWell No. 15 Chitwood twin #4Lion Oil Company

FIRST REPORT

Contractor

NE NW NW

## SECTION PLAT

390 Ft. from N. Line       Ft. from S. Line       Ft. from E. Line990 Ft. from W. Line

0			

Pratt County

Location XRig up       

Drilling and Remarks:

## RECORD

Cased        in.,        ft.Sand       Gas       Oil       Total Depth       

## PRODUCTION

1st 24 hrs. Nat.       1st 24 hrs. after shot       Gas        Cu. Ft.Dry Hole       Abandoned       

Date

OCT 10 1945 19 S. J. LEWIS Scout

KANSAS Kansas Pool Name Chitwood

Map No. 15-54 Sec. 23 Twp. 28 R. 12W

Well No. 15 Chitwood twin #4

Lion Oil Company

**COMPLETED**

Contractor

NE NW NW

E. J. BRYAN  
SECTION PLAT

390

Ft. from N. Line

Ft. from S. Line

Ft. from E. Line

990

Ft. from W. Line

0			

Pratt County

Location \_\_\_\_\_

Rig up \_\_\_\_\_

Drilling and Remarks:

*have 3695.  
7" @ 3698  
1000 acid  
Pump 40 Pst*

*H. E. Ge*

**RECORD**

Cased \_\_\_\_\_ in., \_\_\_\_\_ ft.

Sand \_\_\_\_\_

Gas \_\_\_\_\_

Oil \_\_\_\_\_

Total Depth 3744

**PRODUCTION**

1st 24 hrs. Nat. \_\_\_\_\_

1st 24 hrs. after shot \_\_\_\_\_

Gas \_\_\_\_\_ Cu. Ft.

Dry Hole \_\_\_\_\_

Abandoned \_\_\_\_\_

Date

DEC 1 9 1945 19

S. J. LEWIS

Scout