


Section 23 Township 28 Range 12W

Well No. 16 Chitwood

Company Lion Oil

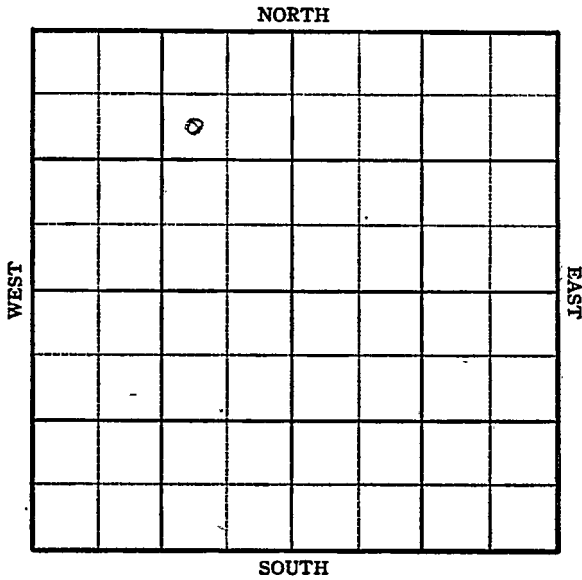

Sec. 23 Twp. 28 R. 12-W

Well No. #16 Chitwood Farm


Lion Oil Company

990 Ft. from N. Line

_____ Ft. from S. Line

990 Ft. from E. Line

_____ Ft. from W. Line

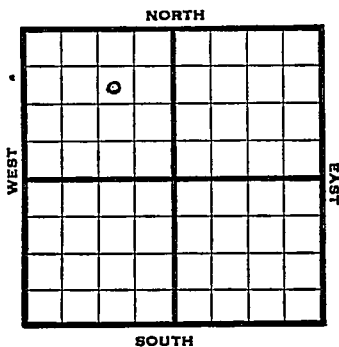

SW NE NW

1945 Elev. 1874

REPORT

10/10 Location

10/17

"

10/24

"

10/31

"

11/7

"

11/14

Derrick

11/21

"

11/28

10" @ 305

Drlg. 347'

12/5

Drlg. 3103'

12/12

Viola 4269

Simp Sd. 4370

4429 fsg.

12/20

" "

12/29

P.B. 2902'

Drlg. 3435'

1946

1/10

T.D. 4469' 5" - 4468' RUST.

1/17

48 shots 4398-4406'

Flow 25 oil per hour.

1/23

Simp Sd. 4370

5" @ 4468

48 shots 4398-4406

TD 4469

Bomb Pot. 1011

Grav. 40.9

COMPLETED

KANSAS Pool Name ChitwoodMap No. 54 Sec. 23 Twp. 28 R. 12WWell No. 16 ChitwoodLion Oil Company

FIRST REPORT Contractor

SW NE NW

SECTION PLAT

990 Ft. from N. Line Ft. from S. Line990 Ft. from E. Line Ft. from W. Line

	o		

Pratt County

Location XRig up

Drilling and Remarks:

RECORD

Cased in., ft.Sand Gas Oil Total Depth

PRODUCTION

1st 24 hrs. Nat. 1st 24 hrs. after shot Gas Cu. Ft.Dry Hole Abandoned

Date

OCT 10 194519S. J. LEWISScout

