

KANSAS


FORM 51 5M PETROL

Pratt

Section 23 Township 28 Range 12-W


Well No. #1 B. ~~Hardesty~~ COLLSON

Company Deep Rock

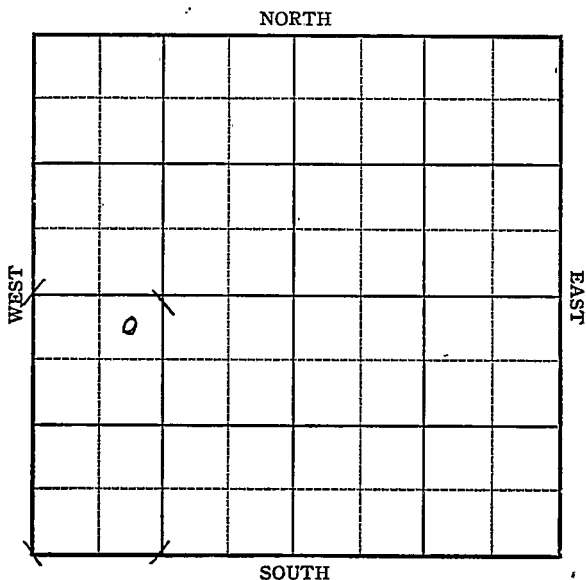

KANSAS

Pratt

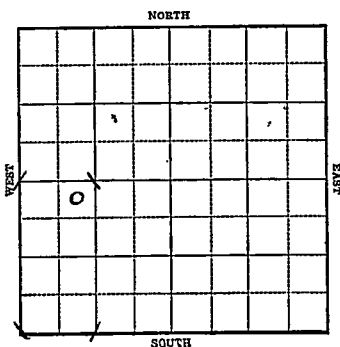Sec. 23 Twp. 28 R. 12-WWell No. #1 B. Hardesty Coulson FarmDeep Rock Company330 Ft. from N. Line Ft. from S. Line Ft. from E. Line990 Ft. from W. LineElev. 1865

1943

R E P O R T

10/27 Location

11/3 8" @ 330

WOC.

11/10 Drlg. 2550

11/17 Drlg. 3739

Lans 8640'

11/24 3931 fsg.

12/1 Whipstock 2300'

12/8 " "

12-15 " "

12/22 SD

12/29 "

1944

1-5 3270 fsg

1-12 Set Whipstock

Drlg 1905'

1/19 Drlg. 2440

1/26 Drlg. 3773'

2/2 Lans 3701

Miss 4150

Drlg. 4200

2/8 Wells 4256

Drlg. 4321

OVER

1944

2/15 Simp 4392
Sand 4395 sat
Arb 4494
TD 4500
5" @ 4493
Rust

2/23 "

3/1 56 shots 4290-4375-4000 acid 8,864,000
gas.

88 shots 4398-4413 flow 35 oil per hr.

3/8 5" @ 4493
Viola 4295
Simp 4395
Arb 4494
TD 4500
88 shots 4398-4413
56 shots 4290-4375
4000 acid
8,964,000 gas
Gravity 41

COMPLETED

KANSAS

Map No. 34 Sec. 23 Twp. 28 R. 12WWell No. 1 B. HardestyDeep Rock

Company

FIRST REPORT

Contractor

NE NW SW

SECTION PLAT

330


Ft. from N. Line

Ft. from S. Line

Ft. from E. Line

990

Ft. from W. Line

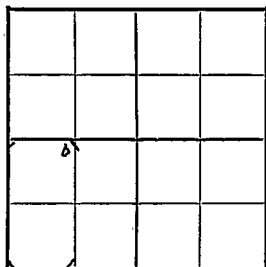Chitwood PoolLocation X

Rig up

Drilling and Remarks:

RECORD

Cased _____ in., _____ ft.

Sand _____

Gas _____

Oil _____

Total Depth _____

PRODUCTION

1st 24 hrs. Nat. _____

1st 24 hrs. after shot _____

Gas _____ Cu. Ft.

Dry Hole _____

Abandoned _____

Date

OCT 27 1943

19

S. J. LEWIS

Scout

Misc. Small Maps

Cards

Trails

France Map

Scarborough Map

Pierce Map

Geological Dept.

Pierce Plat Book

Small

Beet

me

✓

✓

✓

KANSASMap No. 54 Sec. 23 Twp. 28 R. 12WWell No. 1 CoulsonDeep Rock

Company

CORRECTION

Contractor

NE NW SW**SECTION PLAT**330

Ft. from N. Line

Ft. from S. Line

Ft. from E. Line

990

Ft. from W. Line

Chitwood Pool

Location _____

Rig up _____

Drilling and Remarks:

**Reported as
#1 Hardesty****RECORD**

Cased _____ in., _____ ft.

Sand _____

Gas _____

Oil _____

Total Depth _____

PRODUCTION

1st 24 hrs. Nat. _____

1st 24 hrs. after shot _____

Gas _____ Cu. Ft.

Dry Hole _____

Abandoned _____


Date

FEB 23 1944

19

S. J. LEWIS

Scout

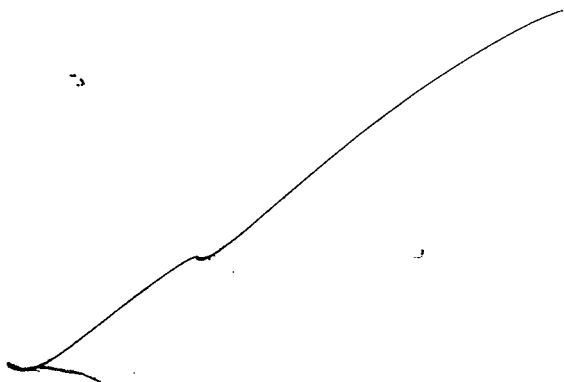

Misc Small Maps	<i>Uma</i>
Cards	<i>Bridge</i>
Tracing	<i>Bridge</i>
France Map	<i>MS</i>
Scarborough Map	<i>MS</i>
Moody Map	<i>MS</i>
Geological Dept.	
Moody Plat Book	

Pratt

KANSAS

Map No. 54 Sec. 23 Twp. 28 R. 12WWell No. 1 CoulsonDeep Rock CompanyCOMPLETED Contractor

NE NW SW

SECTION PLAT

330 Ft. from N. Line

Ft. from S. Line

Ft. from E. Line

990 Ft. from W. Line

Chitwood Pool

Location

Rig up

Drilling and Remarks:

Vidula 4295
Imp. Col 4395
Co 44494
5 104493
88210 to 4395-4419
56 " 4290-4325
4000 acial
Born 42495

Date 964,000 Gal.410 Gal

RECORD

Cased _____ in., _____ ft.

Sand _____

Gas _____

Oil _____

Total Depth 4500

PRODUCTION

1st 24 hrs. Nat. _____

1st 24 hrs. after shot _____

Gas _____ Cu. Ft.

Dry Hole _____

Abandoned _____

MAR 8 1944 19

S. J. LEWIS Scout

Oma
Madge
M. L.

a
ar

body Dep

eological Dept.

body Plat Book