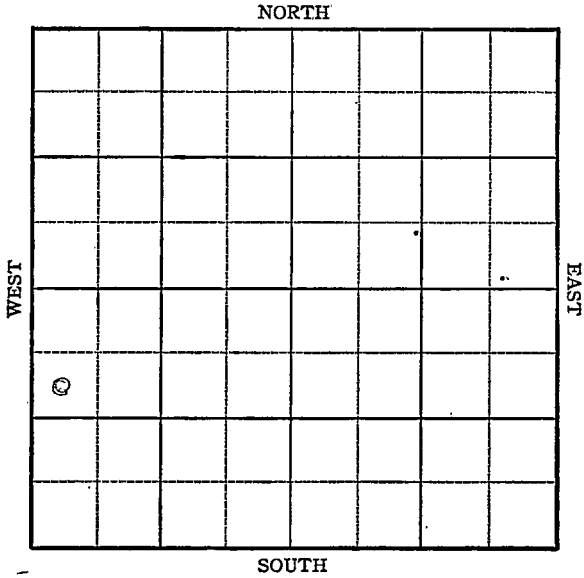


KANSAS

Pratt

FORM 51 5M PETROL

Section 23 Township 28 Range 12WWell No. 3 CoulsonCompany Deep Rock

Sec. 23 Twp. 28 R. 12-W

Well No. #3 Coulson Farm


Deep Rock Company

990 Ft. from N. Line

 Ft. from S. Line

 Ft. from E. Line

330 Ft. from W. Line

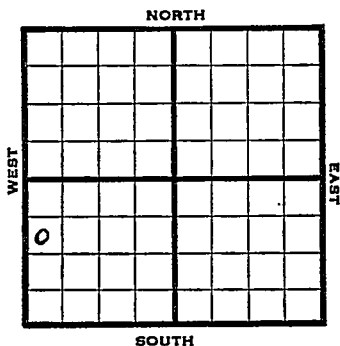

SW NW SW

1945 Elev. 1862 REPORT

10/3 RUR

~~10/3~~ ~~Burrick~~

10/10 Anhy. 205

8" @ 305

Drlg. 2110'

10/17 Drlg. 3440

10/24 Drlg. 4200

10/31 Lans 3712

Vioia 4284

Arb. 4490-4499

TD 4499

Run csg.

11/7 5" @ 4492' RUST

11/14 136 shots 4390-4413

Flow 100 oil per hr.

11/21 " " " "

11/28 " " " "

12/5 " " " "

12/12 Simp. 4381

Arb. 4490

5" @ 4492

Perf. Simp

TD 4499

Echo Pot. 2698

Grav. 40.9

COMPLETED

KANSAS Kansas Pool Name ChitwoodMap No. 54 Sec. 23 Twp. 28 R. 12WWell No. 3 CoulsonDeep Rock Company

FIRST REPORT

Contractor

SW NW SW

SECTION PLAT

990 Ft. from N. Line Ft. from S. Line Ft. from E. Line330 Ft. from W. Line

o			

Pratt CountyLocation Rig up Drilling and Remarks:
RUR

RECORD

Cased in., ft.Sand Gas Oil Total Depth

PRODUCTION

1st 24 hrs. Nat. 1st 24 hrs. after shot Gas Cu. Ft.Dry Hole Abandoned

Date

OCT 3 194519S. J. LEWISScout

KANSAS Kansas Pool Name ChitwoodMap No. 12-54 Sec. 23 Twp. 28 R. 12WWell No. 3 CoulsonDeep Rock Company**COMPLETED**

Contractor

SW NW SW

E 11862
SECTION PLAT990 Ft. from N. Line. Ft. from S. Line Ft. from E. Line330 Ft. from W. Line

6			

Pratt CountyLocation Rig up

Drilling and Remarks:

Simp. #381Ext. #4905" C 4492Prof. SimpEcho #249840. 2 1/2**RECORD**Cased in., ft.Sand Gas Oil Total Depth 4499**PRODUCTION**1st 24 hrs. Nat. 1st 24 hrs. after shot Gas Cu. Ft.Dry Hole Abandoned

Date ,

DEC 12 1945 19S. J. LEWIS Scout