


KANSAS Pratt

FORM 51 5M PETROL

Section 23 Township 28 Range 12W

Well No. 4 Coulson

Company Deep Rock

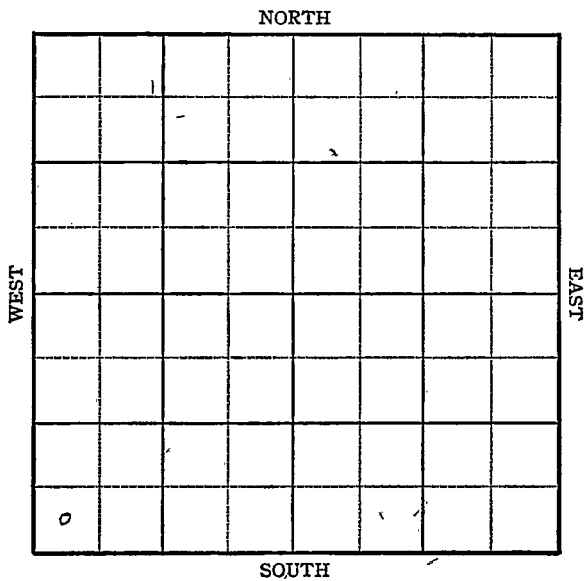

KANSAS Pratt.

Sec. 23 Twp. 28 R. 12-4

Well No. #4 Coulson Farm


Deep Rock Company

 Ft. from N. Line

330 Ft. from S. Line

 Ft. from E. Line

330 Ft. from W. Line

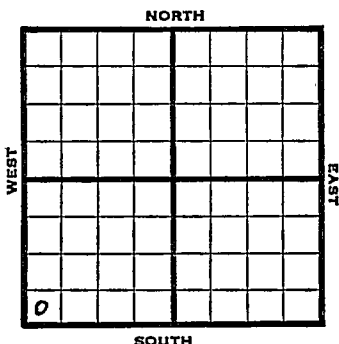

SW/c

1945 Elev. 1854

REPORT

10/3 Location

10/10 "

10/17 RUR

10/24 8" @ 225

Drlg. 2170'

10/31 Drlg. 3545

11/7 Viola 4293

Drlg. 4355'

11/14 Simp Sd. 4380

Arb. 4487

" TD 4485

5" @ 4484 RUST

11/21 136 shots 4392-4412

Flow 75 oil per hr.

11/28 Arb. 4481

Simp 4380

5" @ 4484

Perf. Simp

TD 4485

Bomb Pot. 6048

Max. 3000

Grav. 40.9

COMPLETED

KANSAS Pool Name ChitwoodMap No. 24 Sec. 23 Twp. 28 R. 12WWell No. 4 CoulsonDeep Rock

Company

FIRST REPORT

Contractor

SW/c

SECTION PLAT

 Ft. from N. Line330 Ft. from S. Line Ft. from E. Line330 Ft. from W. Line

Pratt County

Location XRig up

Drilling and Remarks:

RECORD

Cased in., ft.Sand Gas Oil Total Depth

PRODUCTION

1st 24 hrs. Nat. 1st 24 hrs. after shot Gas Cu. Ft.Dry Hole Abandoned

Date

OCT 3 1945 19S. J. LEWIS

Scout

KANSAS

Kansas


Pool Name ChitwoodMap No. 54 Sec. 23 Twp. 28 R. 12WWell No. 4 CoulsonDeep Rock

Company

COMPLETED

Contractor

SW/c

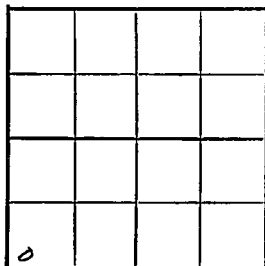E 11854
SECTION PLAT Ft. from N. Line330 Ft. from S. Line Ft. from E. Line330 Ft. from W. Line

Pratt County

Location Rig up

Drilling and Remarks:

Per 4481
Smpl 4380
Per 4484
Per Smpl
Born Per 6048
Map 3000

RECORD

Cased in., ft.Sand Gas Oil Total Depth 4485

PRODUCTION

1st 24 hrs. Nat. 1st 24 hrs. after shot Gas Cu. Ft.Dry Hole Abandoned

Date

NOV 28 1945

19

S. J. LEWIS

Scout