

Section 24 Township 28 Range 1 W
Well No. # 1 Wickham
Company Greenland Drlg.

NORTH

WEST								EAST
							0	

SOUTH

Sedgwick

KANSAS

SEC.	TWP.	R.
24	28	1W

WELL NO.

#1 Wickham

FARM

COMPANY

Greenland Drlg.

CONTRACTOR

Ft. from N. Line


330

Ft. from S. Line

330

Ft. from E. Line

Ft. from W. Line

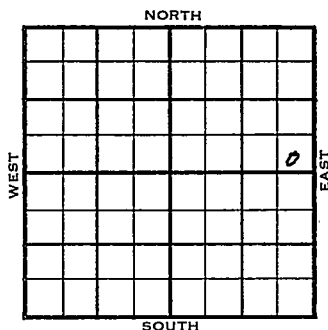

SE SE NE

1954

ELEVATION

1278'

REPORT

12/15


Spud 12-15-54
M I R

12/29

Spud 12-15-54 - D&A
 TD 3220'
 KC 2642', Miss 3142'
 DST 3142-75', opn 1 hr., rec. 10'
 dlrg. mud, 220#
 TD 3220'
 D&A

ABANDONED

County Sedgwick State Kansas
 Sec. 24 (Blk.) 28 (Sur.) 1W Map No.
 Operator Greenland Drlg.
 Well No. 1 Farm Wickham
 Elev. 1278 Location SE SE NE

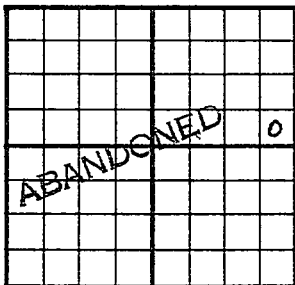

330 Ft. From S Line NE
330 Ft. From E Line Quarter
 1st. Report
 Completion DEC 29 1954
 Remarks
 Spudding Date 12-15-54

Drlg. Data D & A TD 3220
KC 2642 Miss. 3142 DST 3142-75
open 1 hr. Rec. 10' drlg. mud 220#
TD 3220

D & A

FABEN GILSTRAP