


DX 78-1

Section 24 Township 28 Range 1W

Well No. #1 Vickery

Company Francis Raymond

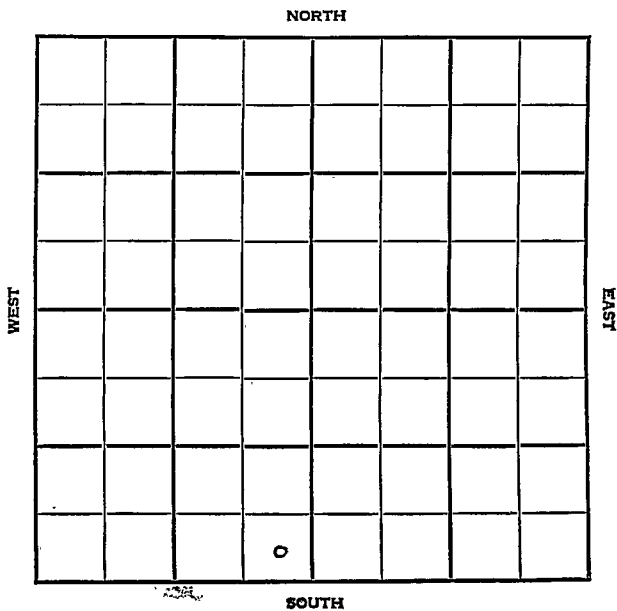

Sedgwick KANSAS


SEC.	TWP.	R.
24	28	1W

WELL NO. 1 Vickery FARM

COMPANY Francis Raymond

CONTRACTOR Murfin Drlg.
Gladys Pool

_____ Ft. from N. Line
 330 _____ Ft. from S. Line
 330 _____ Ft. from E. Line
 _____ Ft. from W. Line

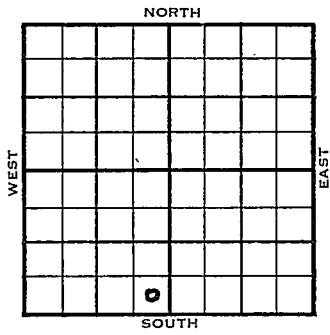

SE SE SW

	ELEVATION	REPORT
1955	1278'	

1/12 Spud 1-8-55
8" @ 167'

1/26 Spud 1-8-55 D & A TD 3285
8" @ 167 Stal. 2375 KG 2723
Cong. 3248 TD 3285
D & A

ABANDONED

