

DX 78-1

Sedgwick

KANSAS

Section 24 Township 28 Range IW


Well No. #1 S. R. Slade

Company Francis Raymond

NORTH

WEST

EAST

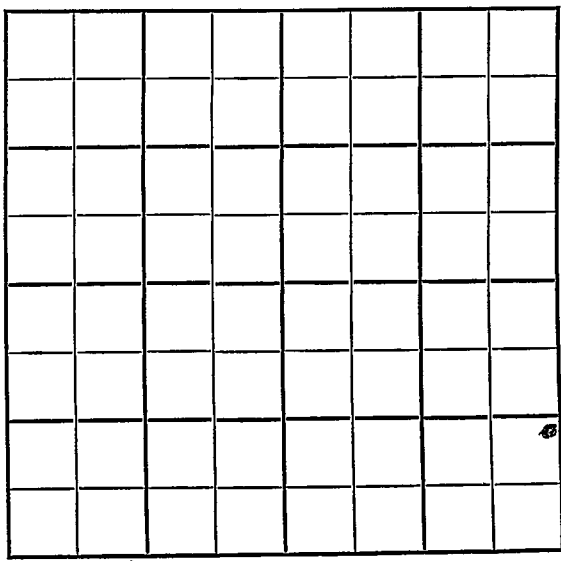

SOUTH

County Sedgwick Elev. 1275
 Sec. 24 Twp. 28 Rge. 1W
 Company Francis Raymond
 Farm Name S. R. Slade No. 1

Co.

TOPS	DEPTH	LOG	DATUM
Anh.			
Tr.			
H.			
Tr.			
Dg.			
Bl.			
L. <u>Stal.</u>	<u>2278</u>		<u>1003</u>
K.C.	<u>2633</u>		<u>1358</u>
B.K.C.			
Ce.			
C. <u>ang</u>	<u>3194</u>		<u>1869</u>
M. <u>idol dol.</u>	<u>3198</u>		<u>1873</u>
M.			
K.			
Mz.			
Me.			
V.			
S.			
S.			
A			
R.			
Pe.			
G.			
T.D.	<u>3213</u>		

Loc. in Sec. NE SE SE
 Geol. _____
 Contr. Greenland
 Pool Gladys

Lse.

TEST REPORT
ABANDONED
 BY 2555

No.

Date Comm. 5-9-55

Sec.

8" @ 163 w/ 175 Cored 3151-82

Rec. 31'

D & A

T.

R.