


Section 24 Township 28 Range 1W

Well No. #1 Doud

Company Francis Raymond

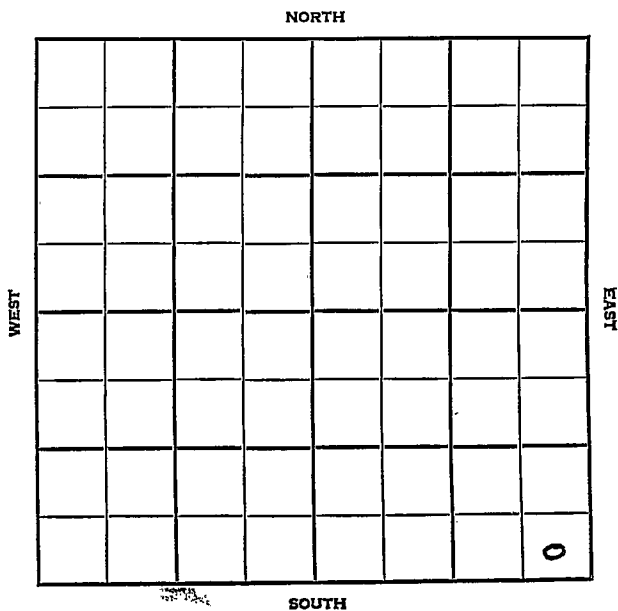

Sedgwick KANSAS

SEC. 24	TWP. - 28	R. 1W
------------	--------------	----------

WELL NO. 1 Doud FARM

COMPANY Francis Raymond

CONTRACTOR Mufin Drlg.


Gladys Pool

\_\_\_\_\_ Ft. from N. Line

330 \_\_\_\_\_ Ft. from S. Line

330 \_\_\_\_\_ Ft. from E. Line

\_\_\_\_\_ Ft. from W. Line

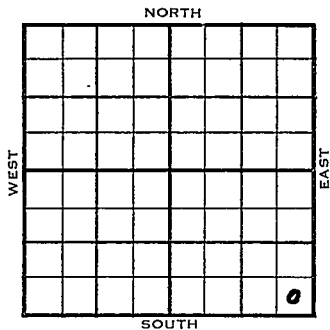

SE SE SE

1955	ELEVATION 1276'	REPORT
------	--------------------	--------

4/13  
6/8

Location  
 Comm. 4-15-55  
 8-5/8" @ 148 w/150  
 DST 2742-56, open 1 hr rec 60' mud.  
 1070/20" 5 1/2" @ 3182 w/75  
 CO to 3190 PB 3168 36/3150-62  
 500 A S/12 BOPH 5 hr. P/40 BO  
 40 BW  
 Comp. 32 BOPD 30% wtr.  
 Stal. 2295', KC 2634', ~~Jan~~ Chat 3134  
 Lm 3141' Dolo 3145'  
 TD 3190'

**COMPLETED**



APR 18 1955

Scout Cards	..... <i>AP</i>
Land Small Map	.....
Land Wall Map	.....
Tracings	.....
France Map	.....
Pierce Map	.....
Misc.	.....

County Sedgwick Elev. 1276  
 Sec. 24-29 Twp. 28 Rge. 1W  
 Company Francis Raymond  
 Farm Name Doud No. 1

TOPS	DEPTH	LOG	DATUM	Loc. in Sec.
Anh. <u>Stat</u>	<u>2295</u>		<u>1019</u>	SE SE SE
Tp.	-			
H.	-			
Tr.	-			
Dg.	-			
Bl.	-			
L.	-			
K.C.	<u>2634</u>		<u>1358</u>	Geol.
B.K.C.	-			Contr.
Ce.	-			
C.	<u>3134</u>		<u>1858</u>	Murfin
M.	<u>3147</u>		<u>1865</u>	
M.	<u>3145</u>		<u>1869</u>	Pool
K.	-			Gladys
Mz.	-			
Ma.	-			
V.	-			
S.	-			
S.	-			
A.	-			
R.	-			
PE.	-			
G.	-			
TD.	<u>3190</u>			

COMPLETE

Date Comm. 4-15-55 JUN 8 1955  
 8 5/8" @ 148/150 DST 2742-56 open 1 hr

Rec. 60' mud 1070/20" 5 1/2" @ 3182/75

CO to 3190 PB 3168 36/ 3150-62

500 A S/ 12 boph 5 hr. P/ 40 bo

40 bw Comp. 32 bopd 30% wtr.

You first reported this well in  
Section 24

~~You are completing it in Section 29.~~  
Please give us a correction for this.

Thanks.

Mickey  
Scouting

Scout Cards	<i>mm</i>
Land Small Map	.....
Land Wall Map	.....
Tracings	.....
France Map	.....
Fierce Map	.....
Misc.	.....

JUL 7 1955