

KANSAS


Grant

Section 24 Township 28 Range 37W

Well No. 1 Walker

Company Hugoton Prod.

Hugoton
NORTH

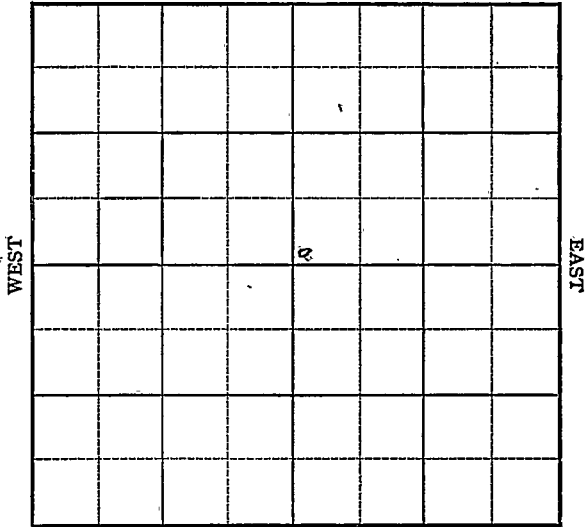

SOUTH

Sec. 24 Twp. 28 R. 37W

Well No. #1 Walker Farm
Hugoton Prod. Company


Hugoton Pool

_____ Ft. from N. Line

100' _____ Ft. from S. Line

_____ Ft. from E. Line

100' _____ Ft. from W. Line

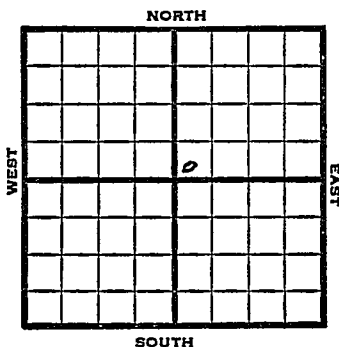

SW NE

1949	Elev 3001' REPORT
3/23	Location
3/30	"
4/6	"
4/12	"
4/20	10" @ 578' Drlg. 590'
4/27	Drlg. 2365'
5/4	TD 2568' 7" @ 2332' 259' of 5" Perf liner @ 2568'
5/10	"
5/18	"
5/25	"
6/1	"
6/7	"
6/15	"
6/21	"
6/29	TD 2568' 7" @ 2332' 259' of 5" Perf Liner @ 2568' 1,597,000 Gas 410# R Pr. Comp COMPLETED

Kansas

Map No. _____ Sec. 24 Twp. 28 R. 37WWell No. 1 WalkerHugoton Prod. CompanyFIRST REPORT Contractor

SW NE

SECTION PLAT

_____ Ft. from N. Line

100 Ft. from S. Line

_____ Ft. from E. Line

100 Ft. from W. Line

		o	

Grant County

Location X

Rig up _____

Drilling and Remarks:

RECORD

Cased _____ in., _____ ft.

Sand _____

Gas _____

Oil _____

Total Depth _____

PRODUCTION

1st 24 hrs. Nat. _____

1st 24 hrs. after shot _____

Gas _____ Cu. Ft.

Dry Hole _____

Abandoned _____

Date

MAR 23 1949

19

S. J. LEWIS

Scout

