


Section 24 Township 28 Range 35W

Well No. #1 Dietz

Company Columbian Fuel

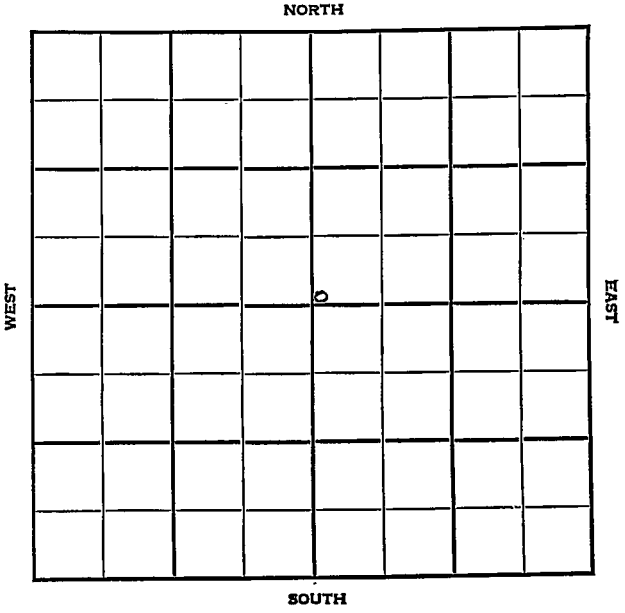

Sec. 24 Twp. 28 R. 35W

Well No. #1 Dietz Farm

Columbian Fuel Company

Hugoton


Ft. from N. Line

100 Ft. from S. Line

Ft. from E. Line

100 Ft. from W. Line

SW NE

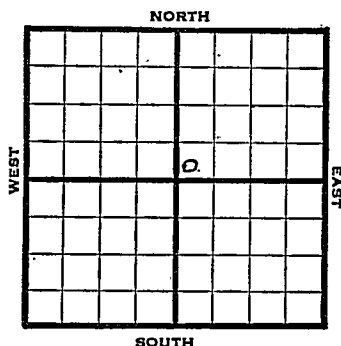

1948 Elev. 3040' REPORT

1/21 Location
1/26 Drlg 575'
2/4 10" @ 618' SD
2/11 TD 2634'
7" @ 2627'
RUST
2/18 Drlg 2720'
2/25 TD 2820'
15,000 acid.
3/31 "
3/10 "
3/17 "
3/24 "
3/31 "
4/7 7" @ 2627'
15,000 Acid
Gas 12,857,000
Rock Pr. 449#
TD 2820'

COMPLETED

Map No. _____ Sec. 24 Twp. 28 R. 35W

Well No. 1 Dietz

Columbian Fuel Company

FIRST REPORT

Contractor

SW NE

SECTION PLAT

_____ Ft. from N. Line

100 Ft. from S. Line

_____ Ft. from E. Line

100 Ft. from W. Line

Grant County

Location X

Rig up

Drilling and Remarks:

RECORD

Cased _____ in, _____ ft.

Sand _____

Gas _____

Oil _____

Total Depth _____

PRODUCTION

1st 24 hrs. Nat. _____

1st 24 hrs. after shot _____

Gas _____ Cu. Ft.

Dry Hole _____

Abandoned _____

Date

JAN 21 1948

19

S. J. LEWIS

Scout

Map No. Sec. 24 Twp. 28 R. 35W

Well No. 1 Dietz

Columbian Fuel Company

COMPLETE

Contractor

SW NE

E 13040
 SECTION PLAT

 Ft. from N. Line

100 Ft. from S. Line

 Ft. from E. Line

100 Ft. from W. Line

		a	

Grant County

Location

Rig up

Drilling and Remarks:

7" 2026 27

15000 Recd

12, 857, 000 Gas

*449 * R/A*

RECORD

Cased in., ft.

Sand

Gas

Oil

Total Depth 2820

PRODUCTION

1st 24 hrs. Nat.

1st 24 hrs. after shot

Gas Cu. Ft.

Dry Hole

Abandoned

Date

APR 7 1948 19

S. J. LEWIS Scout