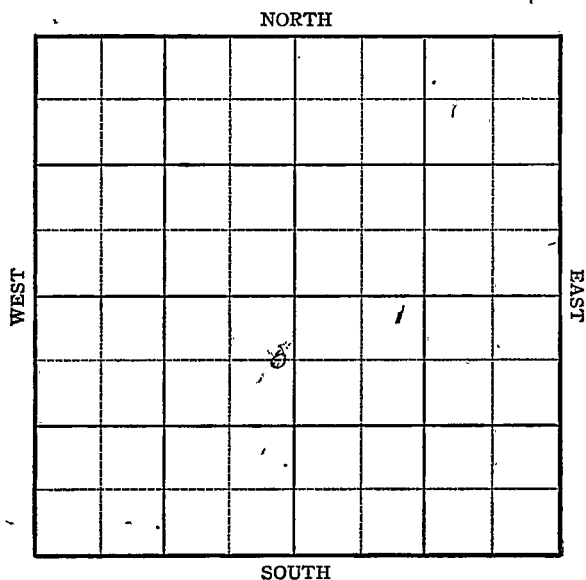


KANSAS

Haskell

FORM 51 5M PETROL

Section 24 Township 28 Range 34WWell No. 1 Lemon "A"Company Cities Service etal

KANSAS Haskell

Sec. 24 Twp. 28 R. 34W

Well No. #1 Lemon "A" Farm


Cities Service etal Company

660 Ft. from N. Line

 Ft. from S. Line

100 Ft. from E. Line

 Ft. from W. Line

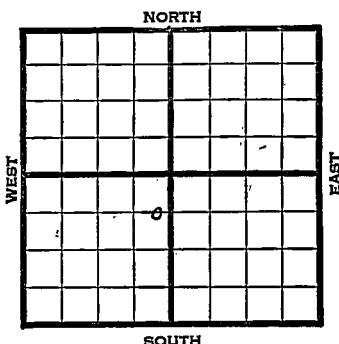

C E L N E SW

1945 Elev. 2987 REPORT

8/8 Location
8/15 8" @ 776 WOC
8/22 5" @ 2796
TD 2797 RUST
8/29 " " "
9/5 " " "
9/12 " " "
9/19 " " "
9/26 78 shots 2615-2770
108,000 Gas
10/3 15000 acid.
10/10 " "
10/17 TD 2797'
10/24 " " "
10/31 5" @ 2796
Perf. 15000 acid;
TD 2797
8,260,000 Gas.
410# R Pr.

COMPLETED

KANSAS
KansasPool Name HugotonMap No. 20 m p Sec. 24 Twp. 28 R. 34WWell No. 1 Lemon "A"

Cities Service etal

Company

FIRST REPORT

Contractor

C E L NE SW

SECTION PLAT

660 Ft. from N. Line Ft. from S. Line100 Ft. from E. Line Ft. from W. Line

HaskellLocation XRig up

Drilling and Remarks:

RECORD

Cased in., ft.Sand Gas Oil Total Depth

PRODUCTION

1st 24 hrs. Nat. 1st 24 hrs. after shot Gas Cu. Ft.Dry Hole Abandoned

Date

AUG 8 1945S. J. LEWIS Scout

Pool Name HugotonKANSAS Kansas
Map No. no map Sec. 24Twp. 28 R. 34WWell No. 1 Lemon "A"


Cities Service etal

Company

COMPLETED

Contractor

C E L NE SW

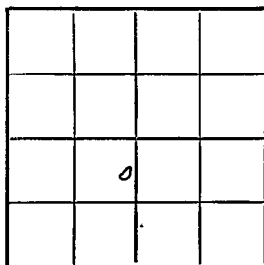E 12987
SECTION PLAT660 Ft. from N. Line Ft. from S. Line100 Ft. from E. Line Ft. from W. Line

Haskell County

Location Rig up

Drilling and Remarks:

510279615000 acid8,260,000 Gas410 R 13**RECORD**Cased in. ft.Sand Gas Oil Total Depth 2297**PRODUCTION**1st 24 hrs. Nat. 1st 24 hrs. after shot Gas Cu. Ft.Dry Hole Abandoned

Date

OCT 3 1 1945

19

S. J. LEWIS Scout