


DX 78-1

Haskell KANSAS

Section 24 Township 28 Range 32 W
Well No. # 1 Weidner
Company Michaelis Drlg.

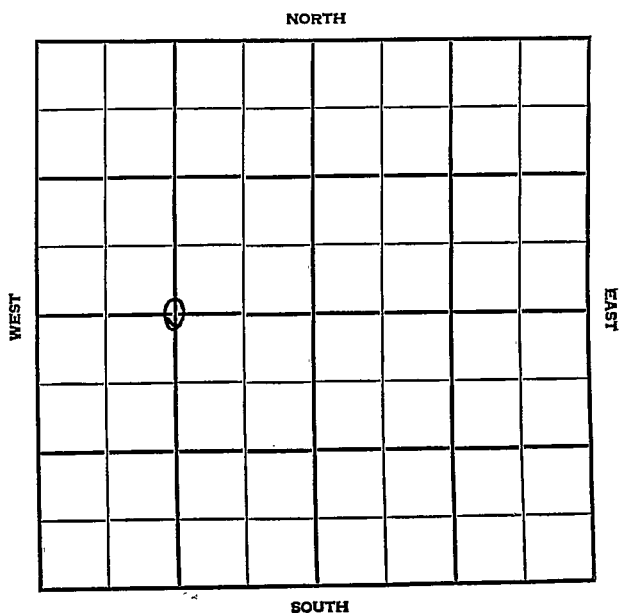

Haskell KANSAS

SEC.	TWP.	R.
24	28	32W

WELL NO.

1 Weidner

FARM

COMPANY

Michaelis Drlg.

CONTRACTOR

Co. Tools


Hugoton Pool

2640 Ft. from N. Line

Ft. from S. Line

Ft. from E. Line

1320 Ft. from W. Line

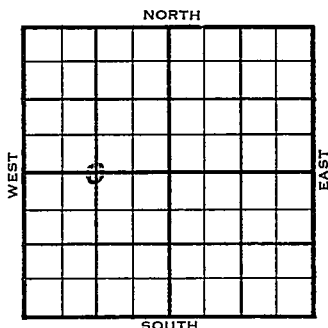

C W/2 Sec.

CSO Farmout

ELEVATION

REPORT

1955

2911'

2/23

Spud 2-20-55

8" @ 517'

Drlg. 1280'

4/6

Spud 2-20-55

Gas Well.

TD 2757'

8" @ 517'

Her. 2702', Kri. 2724'

TD 2757'

5" @ 2756'

CO to 2748'

68/ 2730-47 28/ 2703-10 frac.

2,400,000 cfg. 2,663,000 cfg 5 hr.

Comp 5,874,000 cfgpd. 430#

COMPLETED

County Haskell State KansasSec. 24 (Blk. Twp.) 28 (Sur. Rge.) 32W Map No.Operator Michaelis Drlg.Well No. 1 Farm WeidnerElev. Location C $W\frac{1}{2}$ Sec.

FIRST REPORT


2640 Ft. From N Line Sec.1320 Ft. From W Line Quarter1st. Report FEB 23 1955

Completion

Remarks CSO farmoutCo. toolsSpudding Date 2-20-55Drlg. Data Hugoton Pool8" @ 517 drlg. 1280

FABEN GILSTRAP

County Haskell State Kansas
 Sec. 24 (Blk. 28 (Sur. 32W Map No.)
 (Twp.) (Rge.)
 Operator Michaelis Drlg.
 Well No. 1 Farm Weidner
 Elev. 2911 Location C W $\frac{1}{2}$ Sec.

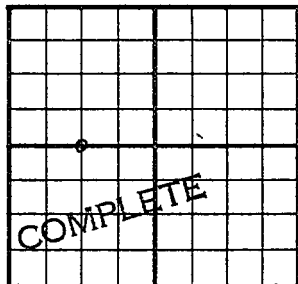

2640 Ft. From N Line Sec.
1320 Ft. From W Line Quarter
 1st. Report
 Completion APR 6 1955
 Remarks Hugoton Pool
Co. tools
 Spudding Date 2-20-55

Drlg. Data Gas well TD 2757
8" @ 517 Her. 2702 Kri. 2724
TD 2757 5" @ 2756 CO to 2748
68/ 2730-47 28/ 2703-10 frac
2,400,000 cfg 2,663,000 cfg 5 hr.
Comp. 5,874,000 cfcpd 430#

FABEN GILSTRAP