

Kiowa

KANSAS

SECTION 24 TOWNSHIP 28S RANGE 19W

WELL NO. #1-Seacat

COMPANY E. K. Carey Drlg.


NW NW

NORTH

WEST

EAST

SOUTH

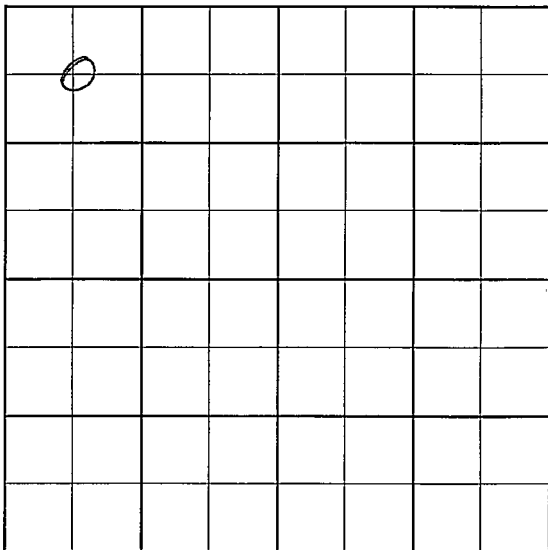

C.O.








Lse.

No.

Sec.

1.


County Kiowa Elev. 2262
 Sec. 24 Twp. 28 Rge. 19W
 Company J. K. Carey drl.
 Farm Name Seacat No. 1

TOPS	DEPTH	LOG	DATUM	Loc. in Sec.
Anh.	1200			7 1/2
Top				
H.		4090		
Tr.				
Dg.				
Bl.				
L.		4250		
K.C.				Geol.
B.K.C.				Contr.
Ce.				Lewis drl.
C.				
M. chat		4854		Pool
M.				J. Hansen
K.				
Mz.				
Ma.				
V.				
S.				
S.				
A.				
R.				
P.				
G.				
T.D.	4914	4912		DEC 4 '57

Date Comm. 7-6-57

E" @ 305/260 drl. 850

1) 4000 JUL 24 '57 Rng 5 1/2 no depo

2) 5' DST 4267-4306 1hr

G 1/5" @ sec 1260' Md 4 9554 011

+ 5' wth 1095/38" DST 4856-78

1hr G 1/2" ga 2.630 MCF 15"

sec 335' MSW BHP 1520/20"

5 1/2 @ 4912 CO 4884 24/4854-60

12' @ 4912 CO 4884 24/4854-60

2, MILCF N.O. 24hr F/ Wtr, PR 4350
 DF 4293-4302 tot 1/3 BOPH 1/2 S 4 BOPH
 to X 4hr of B. RB 4290 148 4284-88 28
 74267-74 S Ave 5 BOPH to X 6 hr 12 S 13 BOPH
 den to 38 BOPH 8 hrs Pky 4350 S 3 1/2 BOPH
 1270 X 12 hr tot S 2.93 BOPH 1990 X 12 hr
 S 1.97 BOPH + .53 BOPH 12 hr to tot AUG 28 '57
 \$ rate 29.29 BOPH + 10.5
 BOPH SEP 4 '57 SEP 11 '57 SEP 18 '57

1 15 BOPH now to
 WOPH SEP 25 '57 OCT 2 '57 OCT 9 '57
 OCT 16 '57 OCT 23 '57 - '57 NOV 6 '57 NOV 13 '57

NOV 20 '57

P 30 BOPH + 10 now
 92 36
 L 4267-4302

NOV 27 '57 DEC 4 '57

24-28-19W

e nw nw