


Section 24 Township 28 Range 8-W

Well No. #1 Davis


Company Carter

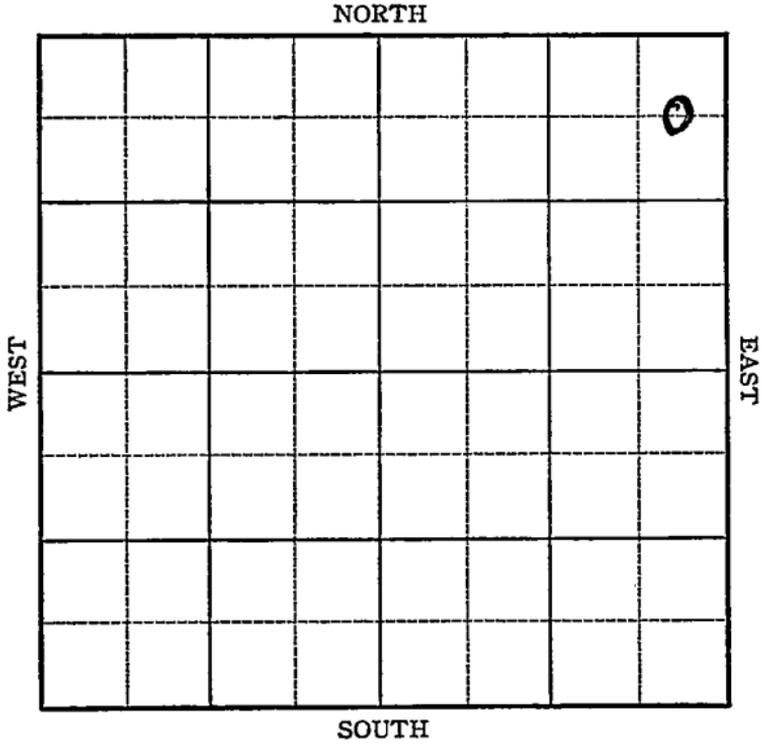

Sec. 24 Twp. 28 R. 8W

Well No. 1-Davis Farm
Carter Company

~~660~~ Ft. from N. Line
 _____ Ft. from S. Line
330 Ft. from E. Line
 _____ Ft. from W. Line
 Elev. 1625

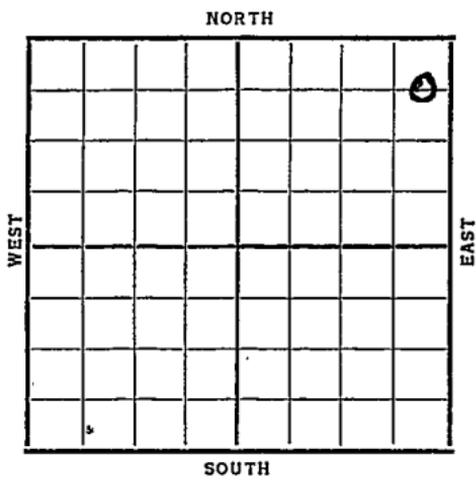

Date	REPORT
1937	
8/11	B.R.R. 4423
8/20	R U R 1625 2798
8/28	12" @ 317'. WOC.
9/3	Drlg. 1915'.
9/10	Drlg. 2825'.
9/17	Topeka 2735'. K.C. 3338'.
	Drlg. 3563'. No shows.
9/24	B. K. C. 3810'. 4070 coring.
10/2	Chat 4075'. S.O. 4098-4122'.
	Reaming.
10/8	" "
10/15	8" @ 4086'. C.O.
10/22	Drilled plug & hole filled
	800' with salt water.
	Drlg. 4184'.
10/29	Cored 4413-47'. No shows.
	Coring.
	OVER

1937

11/3 Viola 4407'.

Simp. 4423'.

Sil. 4538'.

T.D. 4571'.

No shows.

ABANDONED

Map No. 36 Sec. 24 Twp. 28 R8W

Well No. 1 Davis

Carter Company

Contractor

**ABANDONED
C E L N E N E**

660 Ft. from N. Line

_____ Ft. from S. Line

330 Ft. from E. Line

_____ Ft. from W. Line

SECTION PLAT

			0

Location _____

Rig up _____

Drilling and Remarks:

Viola 4407
Simp 4423
sil 4538
TD 4571
No shows

DYA

RECORD

Cased _____ in., _____ ft.

Sand _____

Gas _____

Oil _____

Total Depth _____

PRODUCTION

1st 24 hrs. Nat. _____

1st 24 hrs. after shot _____

Gas _____ Cu. Ft.

Dry Hole _____

Abandoned _____

Date

NOV 3 1937

H. D. Hatfield Scout



Ray

Returned	_____
Cards	<i>Paul</i>
Tracing	<i>Jim</i>
Field Notes	_____
Specimens	<i>Ray</i>
Money	_____
Starboard	_____
Money Paid	_____

KANSAS

Kingman

Map No. 36 Sec. 24 Twp. 28 R. 8 W

Well No. 1 - Davis

Carter Company

Contractor

FIRST REPORT

SECTION PLAT

660 Ft. from N. Line

_____ Ft. from S. Line

330 Ft. from E. Line

_____ Ft. from W. Line

			0

Location _____

Rig up _____

Drilling and Remarks:

B.P.R.

RECORD

Cased _____ in., _____ ft.

Sand _____

Gas _____

Oil _____

Total Depth _____

PRODUCTION

1st 24 hrs. Nat. _____

1st 24 hrs. after shot _____

Gas _____ Cu. Ft.

Dry Hole _____

Abandoned _____

Date

AUG 11 1937

H. D. Hatfield Scout

[Handwritten signature]
[Handwritten signature]

Returned	<i>[Handwritten mark]</i>
Cards	<i>[Handwritten mark]</i>
Tracing	<i>[Handwritten mark]</i>
France Map	<i>[Handwritten mark]</i>
Scarborough Map	<i>[Handwritten mark]</i>
Moody Map	<i>[Handwritten mark]</i>
Scarborough Plat Book	<i>[Handwritten mark]</i>
Moody Plat Book	<i>[Handwritten mark]</i>