


Section 25 Township 28 Range 1W

Well No. #3 Wemple

Company Laura Jane

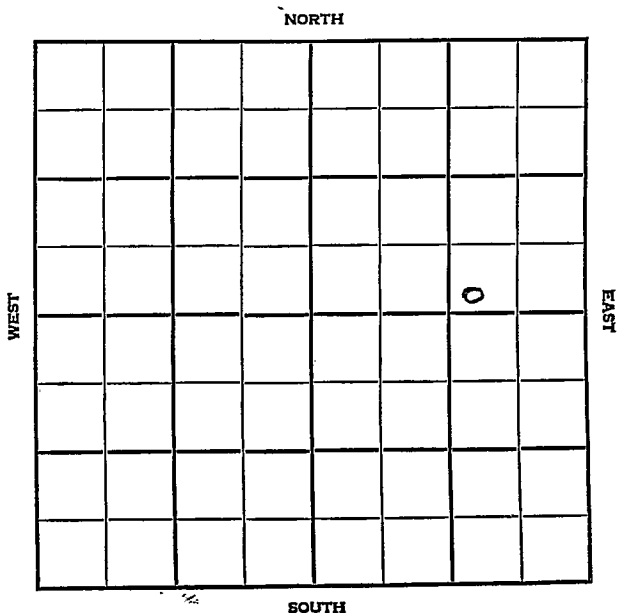

Sedgwick KANSAS


SEC. 25	TWP. 28	R. 1 W
------------	------------	-----------

WELL NO. # 3 Wemple FARM

COMPANY Laura Jane

CONTRACTOR Co. tools Gladys

\_\_\_\_\_ Ft. from N. Line  
 \_\_\_\_\_ Ft. from S. Line  
 \_\_\_\_\_ Ft. from E. Line  
 \_\_\_\_\_ Ft. from W. Line

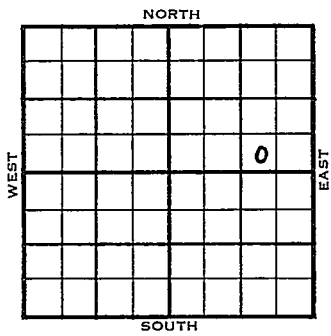

SW SE NE

1955	ELEVATION 1273'	REPORT
6/8	Location	
8/3	Comm 6-9-55	
	8 5/8" @151	
	5 1/2" @3168 CO to 3198 500 A FU 400' oil	
	12 hr. Comp. 120 bopd	
	H. Stal	2296
	KC	2650      1377
	M. Lm	3165      1892
	TD	3198
		COMPLETED

County Sedgwick ✓ Elev. \_\_\_\_\_  
 Sec. 25 Twp. 28 Rge. IW  
 Company Laura Jane  
 FarmName Wemple No. 3

TOPS	DEPTH	LOG	DATUM	Loc. in Sec.									
Anh.				SW SE NE									
Tp.													
H.													
Tr.													
Dg.													
Bl.													
L.				Geol. _____									
K.C.				Contr. _____									
B.K.C.				Co. tools									
Ce.													
C.				Pool									
M.				Gladys									
M.				<table border="1"> <tr> <td colspan="3">FIRST REPORT</td> </tr> <tr> <td></td> <td></td> <td>o</td> </tr> <tr> <td>JUN</td> <td>B</td> <td>'55</td> </tr> </table>	FIRST REPORT					o	JUN	B	'55
FIRST REPORT													
		o											
JUN	B	'55											
K.													
Mz.													
Ma.													
V.													
S.													
S.													
A.													
R.													
PE.													
G.													
T.B.													

Date Comm. \_\_\_\_\_  
 Location \_\_\_\_\_

*K-28*

Co.  
Lse.  
No.  
Sec.  
T.  
R.

County Sedgwick Elev. 1273  
 Sec. 25 Twp. 28 Rgs. 1W  
 Company Laura Jane  
 FarmName Wemple No. 3

TOPS	DEPTH	LOG	DATUM	Loc. in Sec.
Anh.				SW SE NE
TP.				
H. <u>Stal</u>	<u>2296</u>			
Tr.				
Dg.				
Bl.				
L.				
K.C.	<u>2650</u>		<u>1277</u>	Geol.
B.K.C.				Contr.
Ce.				<u>Co. tools</u>
C.				
M. <u>hm</u>	<u>3165</u>		<u>1892</u>	
M. <u>Dolo</u>	<u>3170</u>			Pool
K.				<u>Gladys</u>
Mz.				
Mq.				
V.				
S.				
S.				
A.				
R.				
PE.				
G.				
T.D.	<u>3198</u>			<b>COMPLETE</b>

Date Comm. 6-9-55 'AUG 3 1955  
8 5/8" @ 151 5 1/2" @ 3168 CO to 3198  
500 A FU 400' oil 12 hr.  
Comp. 120 bopd

Co.

Lse.

No.

Sec.

T.

R.