

Sedgwick

KANSAS

SECTION 25 - - TOWNSHIP 28 RANGE 1WWELL NO. #9 WendellCOMPANY Laura Jane

NORTH

						0	

WEST

EAST

SOUTH

Sedgwick KANSAS

SEC. 25	TWP. 28	R. 1W
------------	------------	----------

WELL NO.

#9 Wendell

FARM

COMPANY

Laura Jane

CONTRACTOR

Co. Tools

Gladys


_____ Ft. from N. Line

_____ Ft. from S. Line

_____ Ft. from E. Line

_____ Ft. from W. Line

SW NE SE

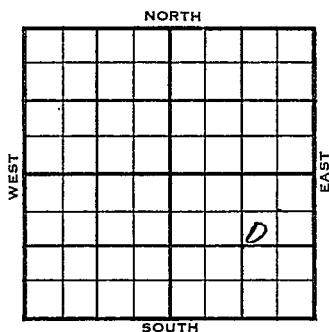

	ELEVATION	REPORT
1956	1273'	

5-9 Comm. 5-7-56

7-3 8 5/8" @ 162 w/165
 Cored 2165-92
 5 1/2" @ 3164
 Pf. 3167, 2173-3186
 1 BOPH, 3000 A
 S & F/ 20 boph, no/wtr.
 P/ 128 bopd, no/wtr.
 Stall. 2320', KC. 2655', M.Chert 3154
 M. Dolo 3164'.
 TD 3192'


COMPLETED

County <u>Sedgwick</u>		Elev. _____	
Sec. <u>25</u>	Twp. <u>28</u>	Rge. <u>1W</u>	
Company <u>Laura Jane</u>		No. <u>9</u>	
Farm Name <u>Wendell</u>			

TOPS	DEPTH	LOG	DATUM
Anh.			
Tp.			
H.			
Tr.			
Dg.			
Bl.			
L.			
K.C.			
B.K.C.			
Ce.			
C.			
M.			
M.			
K.			
Mz.			
Me.			
V.			
S.			
S.			
A.			
R.			
Pe.			
G.			
T.D.			

Loc. in Sec. <u>SW NE SE</u>	
Geol. _____	
Contr. <u>Co. tools</u>	
Pool <u>Gladys</u>	
FIRST REF. MAY 9 1956	

Date Comm. 5-7-56

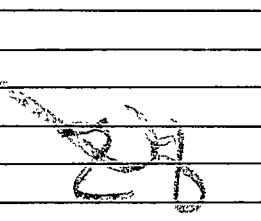

MAY 1 1956

R. G.

County Sedgwick Elev. 1273
 Sec. 25 Twp. 28 Rge. 1W
 Company Laura Jane
 Farm Name Wendell No. 9

TOPS	DEPTH	LOG	DATUM	Loc. in Sec.
Anh.				
Tp. <u>Stall</u>	<u>2320</u>			<u>SW NE SE</u>
H.				
Tr.				<u>1500 SL</u>
Dg.				<u>1050 SL</u>
Bl.				
L.				
K.C.	<u>2455</u>			Geol. _____
B.K.C.				Contr. _____
Ce.				Co. tools _____
C.				Pool _____
M. <u>Chert</u>	<u>3154</u>			<u>Gladys</u>
M. <u>Dolo</u>	<u>3164</u>			
K.				
Mz.				
Ma.				
V.				
S.				
S.				
A.				
R.				
Pe.				
G.				
T.D.	<u>3192</u>			

COMPLETE

JUL 3 1956

Date Comm. 5-7-56 MAY 16 '56 8 5/8 162/16511 2905 MAY 20 '56 CRD 3165-925 1/2 @ 3164 MAY 23 '56 CO JUN 6 '56 COPP 3167, 3173, 3186 (Bear Gun)1 BOPH 3000 A 8+F 20 BOPHNW JUN 13 '56 L JUN 20 '56 JUN 27 '56 JUL 3 '56Ph P. 128 BOPD NW/W