


Sedgwick

KANSAS

SECTION 25 TOWNSHIP 28 RANGE 1 W

WELL NO. #6 Wendle

COMPANY Laura Jane

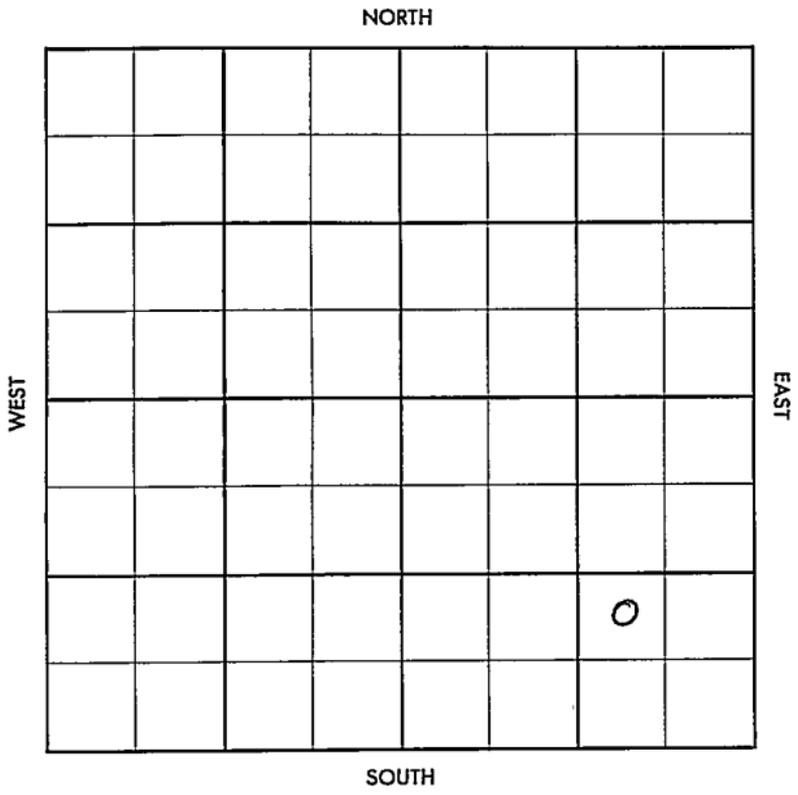

Sedgwick

KANSAS

SEC.	TWP.	R.
25	28	1W

WELL NO. #6 Wendle FARM

COMPANY Laura Jane

CONTRACTOR C&H Tools


Gladys

\_\_\_\_\_ Ft. from N. Line

\_\_\_\_\_ Ft. from S. Line

\_\_\_\_\_ Ft. from E. Line

\_\_\_\_\_ Ft. from W. Line

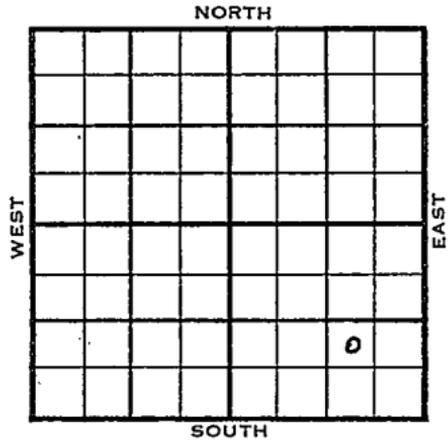

NW SE SE

1955	ELEVATION 1274'	REPORT
------	--------------------	--------

10/26 M I R

11-23 Comm. 10-25-55  
 8 5/8" @ 162/165  
 5 1/2" @ 3162/75  
 CO to 3195  
 S/ 4 BOPH, 3000 A  
 S & F/ 10 BOPH  
 Comp. F/ 321 BOPD  
 Stal 2325-2435  
 Lm. 2657  
 M. lm 3156  
 Dolo 3162  
 TD 3195'

COMPLETED

COMPLETED

County Sedgewick Elev. \_\_\_\_\_  
 Sec. 25 Twp. 28 Rge. 1W  
 Company Laura Jane  
 Farm Name Wendle No. 6

Co.

TOPS	DEPTH	LOG	DATUM
Anh.			
Tp.			
H.			
Tr.			
Dg.			
Bl.			
L.			
K.C.			
B.K.C.			
Ce.			
C.			
M.			
M.			
K.			
Mz.			
Me.			
V.			
S.			
S.			
A.			
R.			
PE.			
G.			
T.D.			

Loc. in Sec. \_\_\_\_\_

NW SE SE

Geol. \_\_\_\_\_

Contr. \_\_\_\_\_

Co. tools

Pool \_\_\_\_\_

Gladys

	OCT 26 55	
FIRST REPORT		

Lse.

No.

Sec.

T.

R.

Date Comm. \_\_\_\_\_

M I R

90  
25

County Sedgwick Elev. 1274  
 Sec. 25 Twp. 28 Rge. 1W  
 Company Laura Jane  
 FarmName Wendle No. 6

Co.

TOPS	DEPTH	LOG	DATUM
Anh. <u>STB</u>	<u>2325</u>	<u>2435</u>	<u>1051</u>
Tr.			
H.			
Tr.			
Dg.			
BL.			
L.			
K.C. <u>same</u>	<u>2657</u>		<u>1383</u>
B.K.C.			
Ce.			
C.			
M. <u>same</u>	<u>31510</u>		<u>1882</u>
M. <u>same</u>	<u>3162</u>		<u>1888</u>
K.			
Mz.			
Mq.			
V.			
S.			
S.			
A.			
R.			
PE.			
G.			
T.D.	<u>3195</u>		

Loc. in Sec. NW SE SE

Geol. \_\_\_\_\_

Contr. Co. tools

Pool Gladys

<b>COMPLETE</b>		

Loc.

No.

Sec.

T.

R.

Date Comm. 10-25-55 NOV 23 1955

8 5/8" @ 162/165 5 1/2" @ 3162/75

CO to 3195 S/ 4 boph 3000 A

S & F/ 10 boph Comp. F/ 321 bopd