


Section 25 Township 28 Range 2-W

Well No. #1 Klausneyer

Company Ed Adair
Wildcat

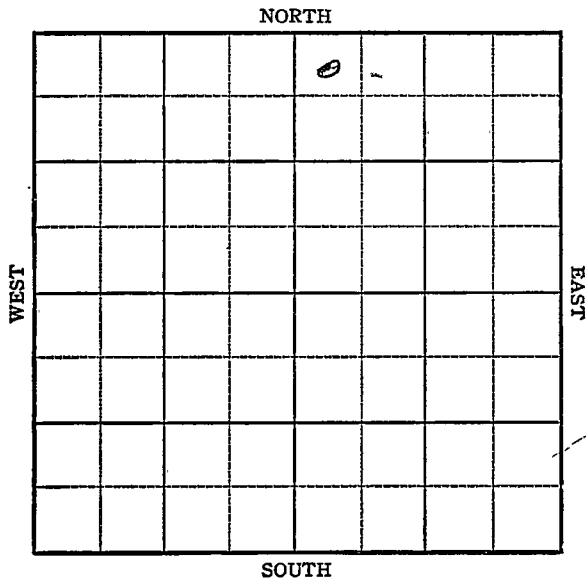

KANSAS

Sedgwick

Sec. 25 Twp. 28 R. 2W

Well No. #1 Klausneyer Farm

Ed Adair Company

Wildcat

NORTH


330' Ft. from N. Line

Ft. from S. Line

Ft. from E. Line

330' Ft. from W. Line

NW NE

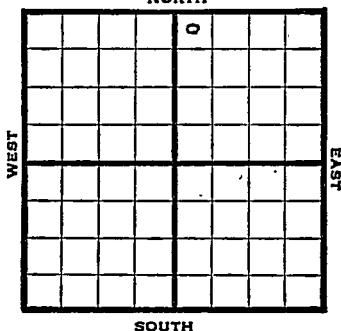

1948

Elev. 1346'

REPORT

1/7 Surface Hole

1/14 Loc

1/21 "

1/26 "

2/4 8" @ 132'
Drlg. 1153'

2/11 KC 2855'
Miss. 3456'
TD 3510'
Abd.

ABANDONED

Map No. _____ Sec. 25 Twp. 28 R. 2W

Well No. 1 Klausneyer

Ed Adair _____ Company

FIRST REPORT _____ Contractor

NW NE


SECTION PLAT

330 Ft. from N. Line

_____ Ft. from S. Line

_____ Ft. from E. Line

330 Ft. from W. Line

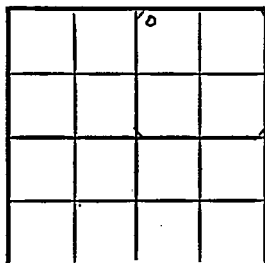

Sedgwick County

Location _____

Rig up _____

Drilling and Remarks:

surface hole

RECORD

Cased _____ in, _____ ft.

Sand _____

Gas _____

Oil _____

Total Depth _____

PRODUCTION

1st 24 hrs. Nat. _____

1st 24 hrs. after shot _____

Gas _____ Cu. Ft.

Dry Hole _____

Abandoned _____

Date

JAN 7 1948 19

S. I. LEWIS Scout

Map No. 38 Sec. 25 Twp. 28 R. 2 W

Well No. 1 Klausneyer

Ed Adair Company

ABANDONED

Contractor

NW NE

E 1/3 1/4

SECTION PLAT

330


Ft. from N. Line

Ft. from S. Line

Ft. from E. Line

330

Ft. from W. Line

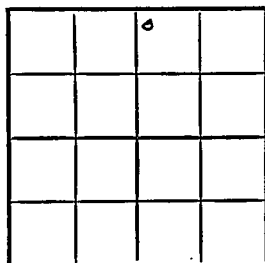

Sedgwick County

Location _____

Rig up _____

Drilling and Remarks:

KC 2855
Miss 3456

RECORD

Cased _____ in., _____ ft.

Sand _____

Gas _____

Oil _____

Total Depth 8510

PRODUCTION

1st 24 hrs. Nat. _____

1st 24 hrs. after shot _____

Gas _____ Cu. Ft.

Dry Hole _____

Abandoned _____

Date

FEB 11 1948

19

S. J. LEWIS Scout