


Section 25 Township 28 Range 37-W

Well No. #1 Patterson

Company Parrish

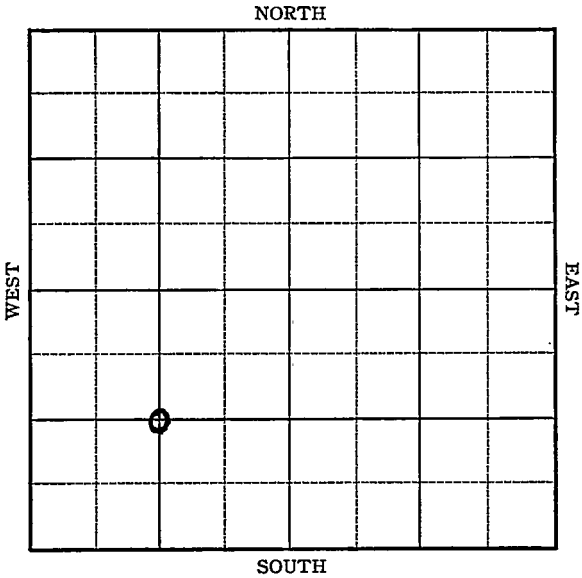

Sec. 25

Twp. 28

R. 37W

Well No. 1- Patterson
Parrish

Farm

Company


_____ Ft. from N. Line

1320 Ft. from S. Line

_____ Ft. from E. Line

1320 Ft. from W. Line

Elv. 2992

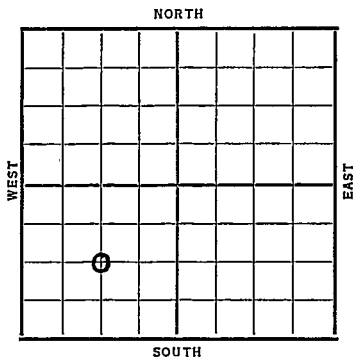

Date	REPORT
1937	
8/11	10" - 375 Dlg. 1750
8/20	7" @ 2342'. WOC.
8/25	Gas Pay 238662408'. Drlg. 2420'. Est. 3 M gas.
9/1	7" @ 2342'. Sand 2366'. T.D. 2627'. 5½ M gas.
	COMPLETED

Grant **KANSAS**Map No. NM Sec. 25 Twp. 28 R. 37WWell No. 1-PattersonParrish Company

Contractor

FIRST REPORT

SECTION PLAT

_____ Ft. from N. Line

1320 Ft. from S. Line

_____ Ft. from E. Line

1320 Ft. from W. Line

Location _____

Rig up _____

Drilling and Remarks:

10"-375Dlg-1750

RECORD

Cased _____ in., _____ ft.

Sand _____

Gas _____

Oil _____

Total Depth _____

PRODUCTION

1st 24 hrs. Nat. _____

1st 24 hrs. after shot _____

Gas _____ Cu. Ft.

Dry Hole _____

Abandoned _____

Date

AUG 11 1937 19H. D. Hatfield Scout

Map No. _____ Sec. 25 Twp. 28 R. 37WWell No. 1 - PattersonParrish

Company

Contractor

COMPLETED**SECTION PLAT**

_____ Ft. from N. Line

1320 Ft. from S. Line

_____ Ft. from E. Line

1320 Ft. from W. Line

Location _____

Rig up _____

Drilling and Remarks:

5 1/2 M gas**RECORD**Cased 7 in., 2342 ft.Sand 2366

Gas _____

Oil _____

Total Depth 2627**PRODUCTION**

1st 24 hrs. Nat. _____

1st 24 hrs. after shot _____

Gas _____ Cu. Ft.

Dry Hole _____

Abandoned _____

Date

SEP 1 1937 19H. D. Hatfield Scout