

DX 78-1

O.W.W.O.


Sedgwick

KANSAS

Section 25 Township 28 S Range 1 W

Well No. #1 Hilda Wemple

Company Laura Jane

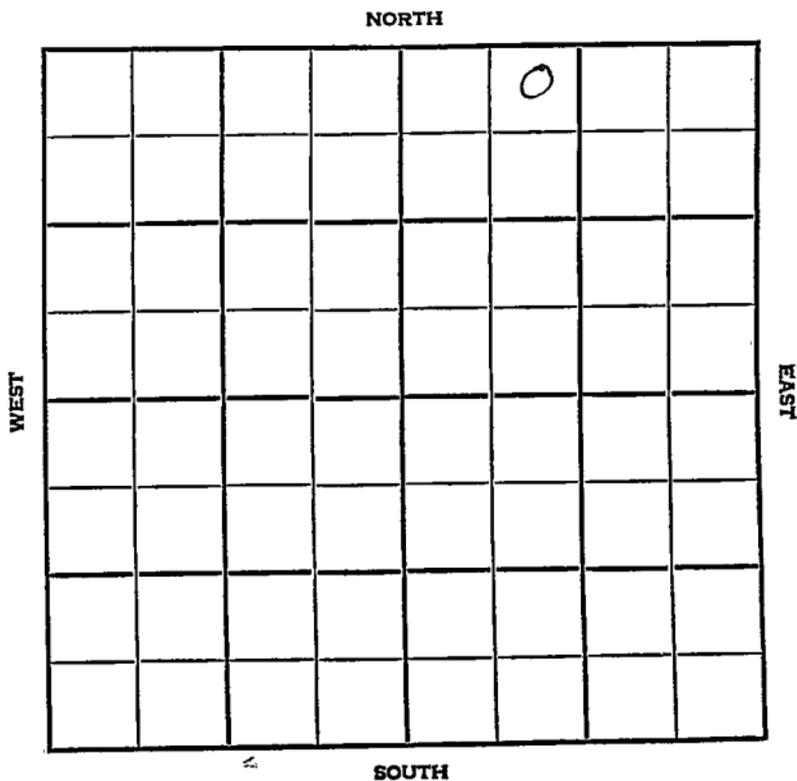

SEDGWICK

KANSAS


SEC.	TWP.	R.
25	28S	IW

WELL NO. #1 Hilda Wemple FARM

COMPANY Laura Jane

CONTRACTOR Gladys

_____ Ft. from N. Line
 _____ Ft. from S. Line
 _____ Ft. from E. Line
 _____ Ft. from W. Line

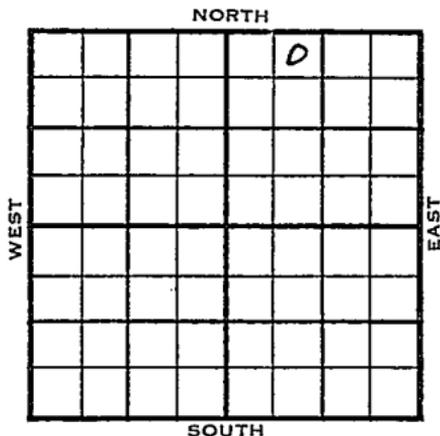

NE NW NE

1955	ELEVATION	REPORT
	1274'	

9/21

RURT

10/26

Compt: 9-20-55
 8 5/8" @ 159
 5 1/2" @ 3151
 KC 2650
 M Lm 3144
 M dolo 3151
 TD 3181
 CO to ~~21~~ 3181 3000 A S/30 boph
 Comp 96 bopd 10% wtr.

COMPLETED


County Sedgewick Elev. _____
 Sec. 25 Twp. 28S Rge. 1W
 Company Aura Jane
 Farm Name Hilda Wemple No. 1

TOPS	DEPTH	LOG	DATUM
Anh.			
TP.			
H.			
Tr.			
Dg.			
BL.			
L.			
K.C.			
B.K.C.			
Ce.			
C.			
M.			
M.			
K.			
Mz.			
Me.			
V.			
S.			
S.			
A.			
R.			
PE.			
G.			
T.P.			

Loc. in Sec. NE NW NE
 Geol. _____
 Contr. _____
 Pool Gladys

FIRST REPORT
 SEP 21 1955

Date Comm. RURT

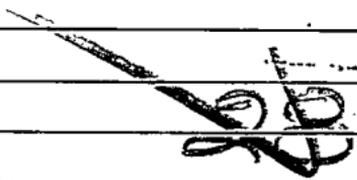

Co.
Lse.
Co.
Sec.
T.
R.

O.W.W.O.

County Sedgwick Elev. 1274 DF
 Sec. 25 Twp. 28S Rge. 1W
 Company Laura Jane
 FarmName Hilda Wemple No. 1
 OWWO

TOPS	DEPTH	LOG	DATUM
Anh.			
TP.			
H.			
Tr.			
Dg.			
Bl.			
L.			
M.C.	2650		
B.K.C.			
Ce.			
C.			
M.	3744		
M. <u>DoI</u>	<u>3151</u>		
K.			
Mz.			
Me.			
V.			
S.			
S.			
A.			
R.			
Pe.			
G.			
T.D.			

Loc. in Sec. NE NW NE
 Geol. _____
 Contr. Laura Jane
 Pool Gladys

Date Comm. FIRST REPORT
RTD 3181; pipe cut off at 2290; setting
whipstock for directional hole to wind
up under dike oct 10 '36

~~89~~

Co.
 Lse.
 No.
 Sec.
 T.
 R.

County Sedgewick Elev. 1774 DF
 Sec. 25 Twp. 28S Rgs. IW
 Company Laura Jane
 Farm Name Hilda Womple No. 1
 OWWO

TOPS	DEPTH	LOG	DATUM	Loc. in Sec.
Anh.				NE NW NE
Tr.				
H.				
Tr.				
Dg.				
Bl.		3052 1/2		
L.				Geol.
K.C.	<u>2950</u>	<u>2652 1/2</u>		Contr.
B.K.C.				<u>Laura Jane</u>
Ce.				Pool
C.				<u>Gladys</u>
M.	<u>311 1/2</u>			
M.	<u>1101</u>	<u>3167 1/2</u>		
K.				
Mz.				
Ma.				
V.				
S.				
S.				
A.				
R.				
Pe.				
G.				
T.D.		<u>3214</u>		

		0
	NOV 29 '56	
COMPLETE		

Date Comm.

NOV 31 1956; pipe cut off at 2290; setting
 whipstock for directional hole to wind
 up under dike OCT 17 '56 ID 1930 to
 reset whip stock OCT 24 '56 ID 3027
 OCT 31 '56 ✓ 5' 1/2 @ 3213 NOV 7 '56 DD
 measured 3215 vert 3204 1/2 \$ 8.
 Boph no/wt NOV 12 '56 NOV 21 '56 ✓ NOV 28 '56
 P. 150 Bopd no/wt