


Section 25 Township 28 Range 12W

Well No. 1 Miller

Company O'Dell Prod. etal

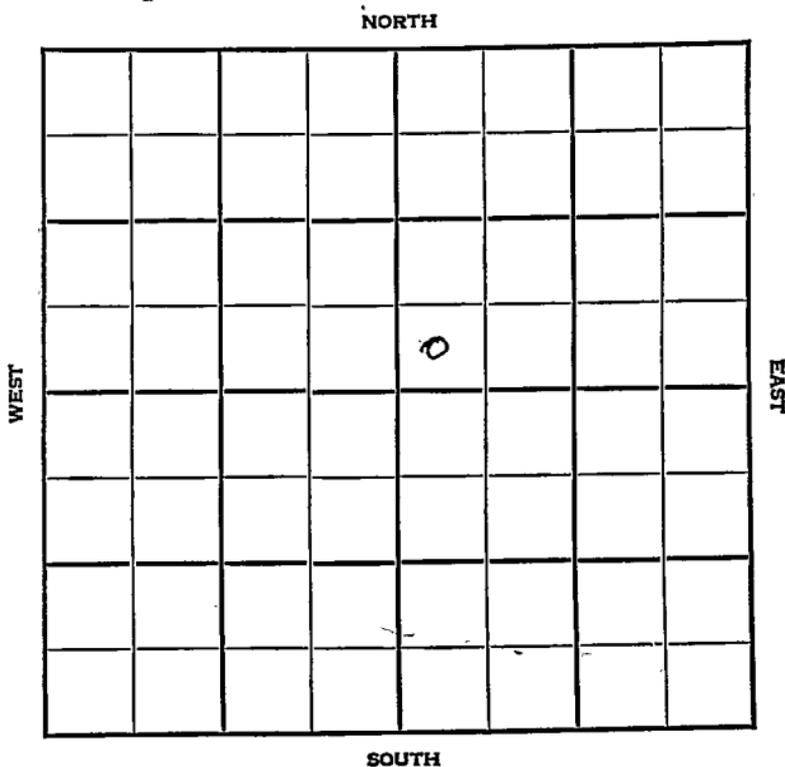

Sec. 25 **KANSAS** Twp. 28 R. 12-W

Well No. #1 Miller Farm

O'Dell Prod. et al Company

Wildcat


 Ft. from N. Line

330' Ft. from S. Line

 Ft. from E. Line

330' Ft. from W. Line

SW NE

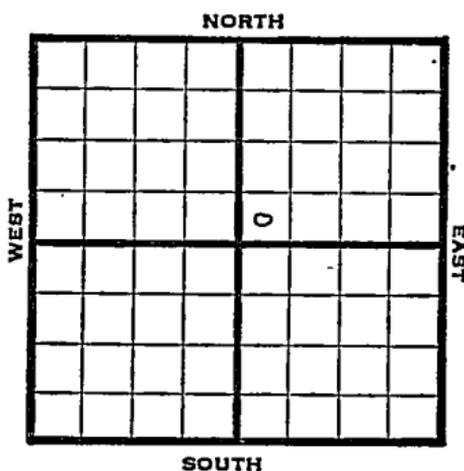

1947

Elev. 1849' REPORT

12/10

Loc.

12/17

"

12/30

"

1948

1/7

10" @ 675' WOB

1/14

Drlg 2976'

1/21

KC 3721'
Drlg. 3980'

1/26

Mississippi 4192'
4382' gsg.

2/4

Viola 4389'
Simp. 4489'
Arb. 4599'
TD 4636'
Abd.

ABANDONED

Map No. _____ Sec. 25 Twp. 28 R. 12W

Well No. 1 Miller

O'Dell Prod. etal. Company

FIRST REPORT

Contractor _____

SW NE


SECTION PLAT

_____ Ft. from N. Line

330 Ft. from S. Line

_____ Ft. from E. Line

330 Ft. from W. Line

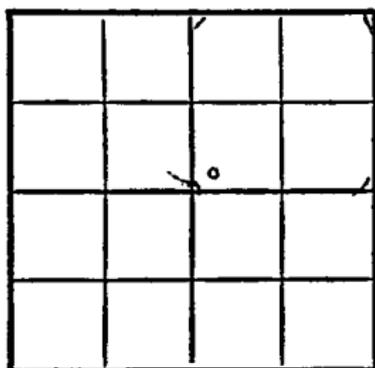

Pratt County

Location X

Rig up _____

Drilling and Remarks:

RECORD

Cased _____ in., _____ ft.

Sand _____

Gas _____

Oil _____

Total Depth _____

PRODUCTION

1st 24 hrs. Nat. _____

1st 24 hrs. after shot _____

Gas _____ Cu. Ft.

Dry Hole _____

Abandoned _____

Date

DEC 10 1947 19

S. J. LEWIS Scout

