

Grant


KANSAS

Section 26 Township 28 Range 37W

Well No. #1-26 Grosshart

Company ~~Hugoton~~ PANTHANDLS EASTERN

NORTH

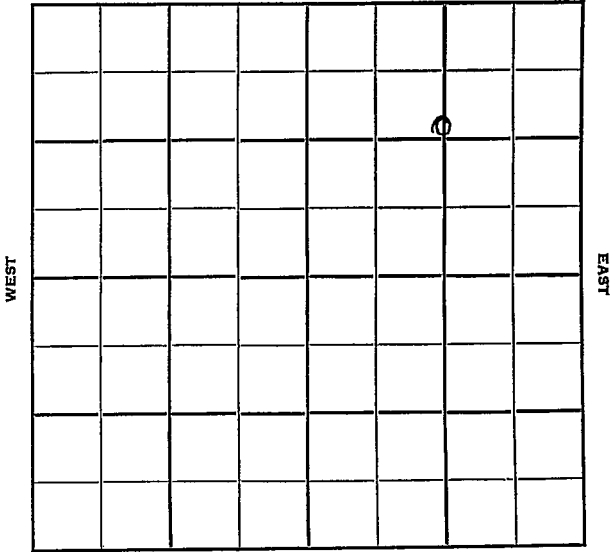

SOUTH

WEST

EAST

Sec. 26 Twp. 28 R. 37W

Well No. #1-26 Grosshart Farm _____
Panhandle Eastern
Hugoton Company _____

Moran Contractor _____


1270 Ft. from N. Line

_____ Ft. from S. Line

1320 Ft. from E. Line

~~1320~~ Ft. from W. Line

~~CSL N/2 NW~~
~~CSL N/2 NE~~

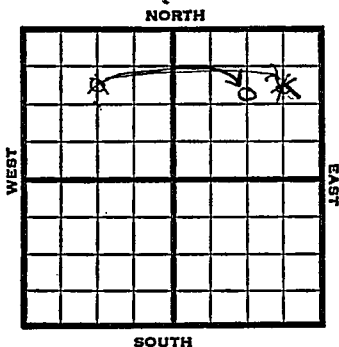

1951

Elev. 2997'

REPORT

11/28	Location
1952	
2/6	TD 2578 7" @ 2328
2/13	Her 2333 Kri 2364-2413 Win 2422-63 Up Ft. 2481 Lower Ft. 2548
2/20	NR
3/5	"
3/12	"
3/19	"
3/25	NR
4/1	NR
4/9	"
4/23	"
4/30	"
5/7	"
5/14	"
5/21	"
5/28	"
6/11	"
6/18	Drlg. 2676'
6/25	TD 2701' PB 2650' 19,500 A

OVER

1952

7/2

Spud 11-28-51

Gas well TD 2701' 10" @ 563

7" @ 2328' TD 2578' Her. 2333'

Kri. 2364-2413' Win. 2422-63'

Ft. Riley 2481' TD 2701'

PB 2650' 29,000 A

Comp. 25,477,000 gas. 359#

COMPLETED

County Grant State Kansas

Sec. 26 (Blk. 28) (Sur. Rge.) 37W Map No.

Operator Hugoton

Well No. 1-26 Farm Grosshart

Elev. Location GSL N/2 NW

1270 Ft. From N Line NW

1320 Ft. From W Line Quarter

Ist. Report NOV 28 1951

Completion

Remarks

Moran - Contr.

Spudding Date

Drlg. Data

Location

see correction

J. E. TYRA

Scout Cards	mk
Land Small Map	
Land Wall Map	3
Tracings	
France Map	
Pierce Map	
MISC.....	

DEC 7 1951

Kansas

Map No. _____ Sec. 26 Twp. 28 R. 37W

Well No. 1-26 Grosshart

Hugoton Prod. Company

CORRECTION

Contractor

C S L $N\frac{1}{2}$ NE

SECTION PLAT

1270 Ft. from N. Line

_____ Ft. from S. Line

1320 Ft. from E. Line

_____ Ft. from W. Line

			0

Grant County

Location _____

Rig up _____

Drilling and Remarks:

Reported

C S L $N\frac{1}{2}$ NW

RECORD

Cased _____ in., _____ ft.

Sand _____

Gas _____

Oil _____

Total Depth _____

PRODUCTION

1st 24 hrs. Nat. _____

1st 24 hrs. after shot _____

Gas _____ Cu. Ft.

Dry Hole _____

Abandoned _____

Date

DEC 5 1951

19

J. E. TYRA Scout



- Scout Cards *my*
- Land Small Map
- Land Wall Map *2*
- Tracings
- France Map
- Pierce Map
- Misc.

DEC 10 1951

Map No. _____ Sec. 26 Twp. 28 R. 37W

Well No. 1 - 26 Grosshart

Panhandle Eastern _____ Company

_____ Contractor

CSL N/2 NE


1270 Ft. from N. Line

_____ Ft. from S. Line

1320 Ft. from E. Line

_____ Ft. from W. Line

SECTION PLAT

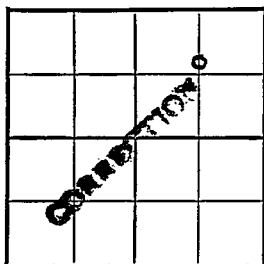

Location _____

Rig up _____

Drilling and Remarks:

Reported

Hugoton Prod.

RECORD

Cased _____ in., _____ ft.

Sand _____

Gas _____

Oil _____

Total Depth _____

PRODUCTION

1st 24 hrs. Nat. _____

1st 24 hrs. after shot _____

Gas _____ Cu. Ft.

Dry Hole _____

Abandoned _____

Date

APR 16 1952

J. G. McGEHEE


Scout Cards

Land Small Map

Land Wall Map

Tracings

FRANCE MAP

 

Pierce Map

Misc.

1952

APR 18 1952

Scout Cards	
Land Small Map	
Land Wall Map	3
Tracings	
France Map	
Pierce Map	
Misc.	

JUL 9 1952

Scout Cards	mm
Land Small Map	
Land Wall Map	B
Trainings	
Finance Map	
Pierce Map	
MISC	

Drig. Data

County Grant State Kansas

Sec. 26 (Blk. Twp.) 28 (Sur. Rge.) 37W Map No.

Operator Panhandle Eastern

Well No. 1-26Farm Grosshart

Elev. 2997 Location C S L N $\frac{1}{2}$ NE

1270 Ft. From N Line NE

1320 Ft. From E Line Quarter

1st. Report

Completion JUL 2 1952

Remarks

Moran - Contr.

Spudding Date 11-28-51

Drlg. Data Gas well TD 2701

10" @ 563 7" @ 2328 TD 2578

Her. 2333 Kri. 2364-2413 Win. 2422-63

Ft. Riley 2481 TD 2701 PB 2650

29000 A Comp. 25,477,000 gas 359#