


Grant

KANSASSection 26 Township 28 Range 38NWell No. #1 KingCompany Stanolind

NORTH

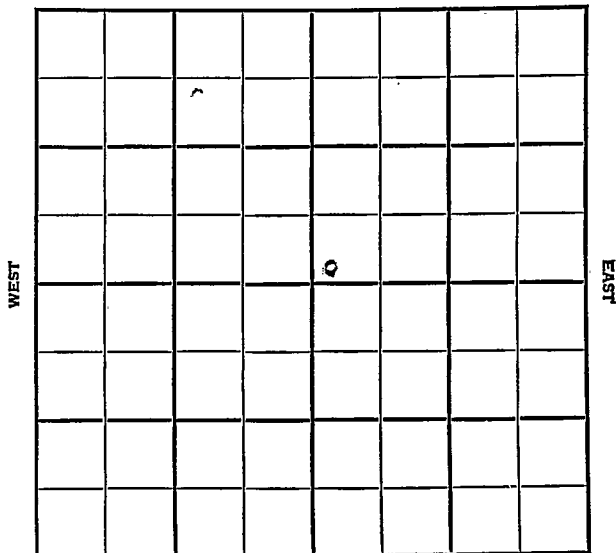

SOUTH

KANSAS

Grant

Sec. 26 Twp. 28 R. 38W

Well No. #1 King Farm

Stanolind Company  
Hugoton


Ft. from N. Line

150 Ft. from S. Line

Ft. from E. Line

150 Ft. from W. Line

SW NE

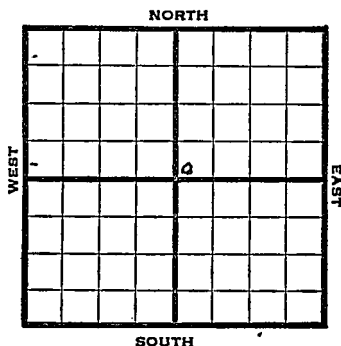

1947

Elev. 3098' REPORT

10/8 Drlg. 1200'

10/15 7" @ 2385' TD

10/22 10" @ 659  
Drlg. 2487'

11/5 7" @ 2385'  
224' of 5" Perf liner @ 2595'  
Acid 17,000  
Gas 10,400,000  
Rock Pressure 415#  
Total Depth 2595'

**COMPLETED**

Map No. \_\_\_\_\_ Sec. 26 Twp. 28 R. 38W

Well No. 1 King


Stanolind Company

**FIRST REPORT**

Contractor \_\_\_\_\_

SW NE

**SECTION PLAT**

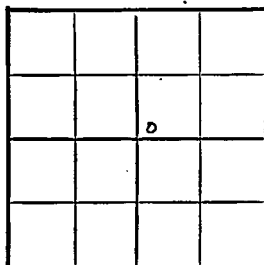

6 Ft. from N. Line

150 Ft. from S. Line

\_\_\_\_\_ Ft. from E. Line

150 Ft. from W. Line

Grant County

Location \_\_\_\_\_

Rig up \_\_\_\_\_

Drilling and Remarks:

drlg. 1200

**RECORD**

Cased \_\_\_\_\_ in., \_\_\_\_\_ ft.

Sand \_\_\_\_\_

Gas \_\_\_\_\_

Oil \_\_\_\_\_

Total Depth \_\_\_\_\_

**PRODUCTION**

1st 24 hrs. Nat. \_\_\_\_\_

1st 24 hrs. after shot \_\_\_\_\_

Gas \_\_\_\_\_ Cu. Ft.

Dry Hole \_\_\_\_\_

Abandoned \_\_\_\_\_

Date

OCT 8 1947 19 \_\_\_\_\_ S. J. LEWIS Scout

*[Handwritten signature]*

|                  |                   |
|------------------|-------------------|
| Misc. Small Maps | _____             |
| Cards            | <i>Ruth</i> _____ |
| Tracing          | _____             |
| France Map       | _____             |
| Coal Lough Map   | _____             |
| Pierce Map       | _____             |
| Cec'cal Dept.    | _____             |
| Pierce Play Form | _____             |

Map No. \_\_\_\_\_ Sec. 26 Twp. 28 R. 38W


Well No. 1 King

Stanolind Company

COMPLETE Contractor

SW NE

E13098  
SECTION PLAT

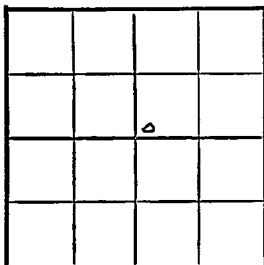

\_\_\_\_\_ Ft. from N. Line

150 Ft. from S. Line

\_\_\_\_\_ Ft. from E. Line

150 Ft. from W. Line

Grant County

Location \_\_\_\_\_

Rig up \_\_\_\_\_

Drilling and Remarks:

7" @ 2385

224' of 5" Perf. pipe

@ 2395

17000 cu. ft.

10,400,000 Gas

415 \* RA

RECORD

Cased \_\_\_\_\_ in., \_\_\_\_\_ ft.

Sand \_\_\_\_\_

Gas \_\_\_\_\_

Oil \_\_\_\_\_

Total Depth 2395

PRODUCTION

1st 24 hrs. Nat. \_\_\_\_\_

1st 24 hrs. after shot \_\_\_\_\_

Gas \_\_\_\_\_ Cu. Ft.

Dry Hole \_\_\_\_\_

Abandoned \_\_\_\_\_

Date

NOV 5 1947 19 S. J. LEWIS Scout

Misc. Small Maps

Cards

Tracing

France Map

Scarborough Map

Force Map

Logical Dept.

Flat Eeck