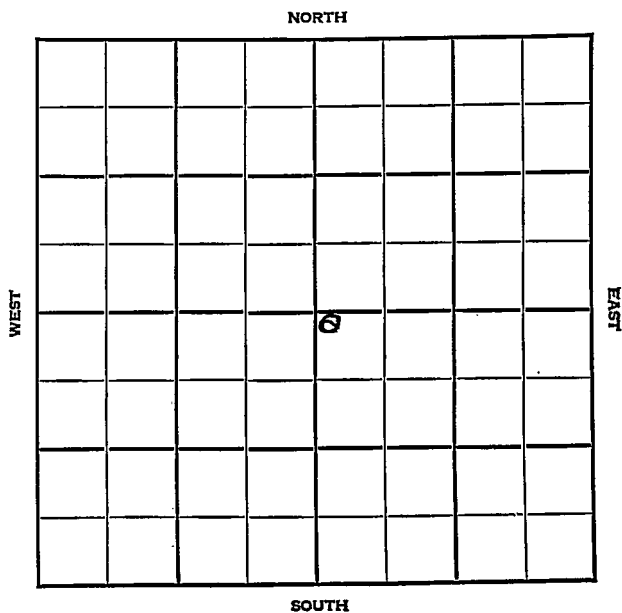


KANSAS

Grant

Section 26 Township 28 Range 36WWell No. #1 Gano "C"Company Columbian Fuel

KANSAS

Grant

✓


Sec. 26 Twp. 28 R. 36W

Well No. #1 Gano "C" Farm

Columbian Fuel

Company

Hugoton Pool

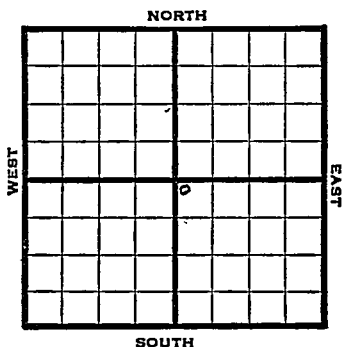

100' Ft. from N. Line

Ft. from S. Line

Ft. from E. Line

100' Ft. from W. Line

NW SE

1948	Eli 3062'	REPORT
6/9	Locationn	
6/16	10" @ 546'	
	DrPg. 1803'	
6/23	7" @ 2515'	
	TD 2523'	
6/29	TD 2707'	
7/14	TD 2707'	
	7"@ 2514'	
	128' of 5" perf liner @ 2707'	
	15,000 acid 11,696,000 Gas	
	396# R Pr.	
	Comp.	
	COMPLETED	

Map No. _____ Sec. 26 Twp. 28 R. 36W

Well No. 1 Gano "C"

Columbian Fuel Company

FIRST EFFORT Contractor

NW SE

SECTION PLAT

100 Ft. from N. Line

_____ Ft. from S. Line

_____ Ft. from E. Line

100 Ft. from W. Line

		o	

Grant County

Location X

Rig up _____

Drilling and Remarks:

RECORD

Cased _____ in., _____ ft.

Sand _____

Gas _____

Oil _____

Total Depth _____

PRODUCTION

1st 24 hrs. Nat. _____

1st 24 hrs. after shot _____

Gas _____ Cu. Ft.

Dry Hole _____

Abandoned _____

Date

JUN 9 1948

19

S. J. LEWIS

Scout

Map No. _____ Sec. 26 Twp. 28 R. 36WWell No. 1 Gano "C"

Columbian Fuel

Company

COMPLETE

Contractor

NW SE

E1, 3062
SECTION PLAT100 Ft. from N. Line

_____ Ft. from S. Line

_____ Ft. from E. Line

100 Ft. from W. Line

		0	

Grant County

Location _____

Rig up _____

Drilling and Remarks:

7" @ 2514
128' of 5" Perf. line
@ 2707
15000 acc. C
11,696,000 Gas

396 # R/R

RECORD

Cased _____ in., _____ ft.

Sand _____

Gas _____

Oil _____

Total Depth 2707

PRODUCTION

1st 24 hrs. Nat. _____

1st 24 hrs. after shot _____

Gas _____ Cu. Ft.

Dry Hole _____

Abandoned _____

Date

JUL 14 194819S. I. LEWIS Scout