

KANSAS


Kiowa County

FORM 51 5M 6-46 PETROL

Section 26 Township 28 Range 17W

Well No. #1 Nora

Company Phillips

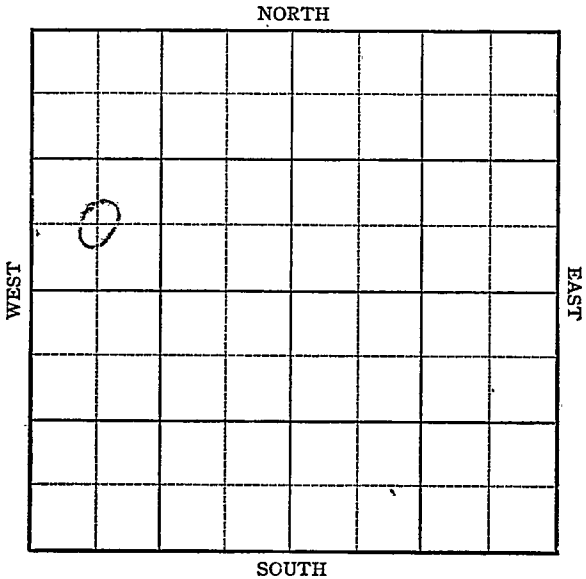

KANSAS

Kiowa County



Sec. 26 Twp. 28 R. 17W

Well No. #1 Nora Farm
Phillips Company


Wildcat

Ft. from N. Line

660 Ft. from S. Line

Ft. from E. Line

660 Ft. from W. Line

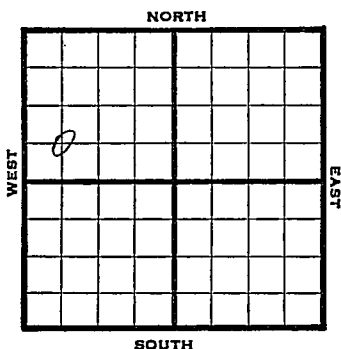

CSW NW

1946 2/8/ Elev. REPORT

7/10 Location
7/16 Anhy 1080'
1120' Drlg
7/23 10" @ 1106
Drlg 2570'
7/30 Drlg 4003'
8/6 Douglas 4100
Lans 4233
Drlg 4693'
8/14 Cong 4780
Miss 4797
Kind 4885
Viola 4915
Simp 4044
Arb. 5108
TD 5202'

ABANDONED

KANSAS

Kansas Pool Name WildcatMap No. 91 Sec. 26 Twp. 28 R. 17WWell No. 1 NoraPhillips

Company

FIRST REPORT

Contractor

C S W NW

SECTION PLAT

o			

Ft. from N. Line

660 Ft. from S. Line

Ft. from E. Line

660 Ft. from W. LineKiowa CountyLocation X

Rig up

Drilling and Remarks:

RECORD

Cased _____ in., _____ ft.

Sand _____

Gas _____

Oil _____

Total Depth _____

PRODUCTION

1st 24 hrs. Nat. _____

1st 24 hrs. after shot _____

Gas _____ Cu. Ft.

Dry Hole _____

Abandoned _____

Date

JUL 10 1946 19S. J. LEWIS Scout

KANSAS Pool Name Wildcat
 Map No. 97 Sec. 26 Twp. 28 R. 17W
 Well No. 1 Nora

Phillips

Company

ABANDONED

Contractor

C SW NW

E 1/2/8/

SECTION PLAT

Ft. from N. Line

660

Ft. from S. Line

Ft. from E. Line

660

Ft. from W. Line

0			

Kiowa County

Location

Rig up

Drilling and Remarks:

Crng 4780
Wid 4797
Kind 4885
Vid 4915
Sing 4044
Per 5108.

RECORD

Cased _____ in., _____ ft.

Sand _____

Gas _____

Oil _____

Total Depth 5202

PRODUCTION

1st 24 hrs. Nat. _____

1st 24 hrs. after shot _____

Gas _____ Cu. Ft.

Dry Hole _____

Abandoned _____

Date

AUG 14 1946 19

S. J. LEWIS Scout