


DX 78-1 Ford

KANSAS

Section 26 Township 28 Range 23W

Well No. #1 Polson

Company Kewanee Oil

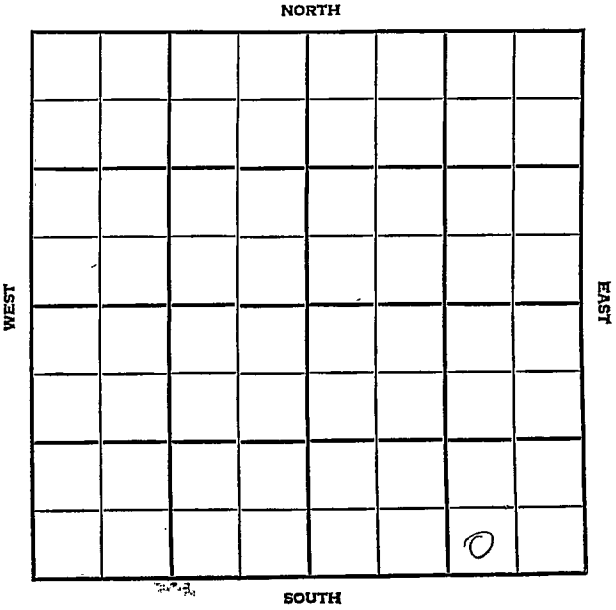

Ford

KANSAS

SEC.

26

TWP.

28
30

R.

23W

WELL NO.

#1 Polson

FARM

COMPANY

Kewanee Oil

CONTRACTOR

G-M

WILDCAT


_____ FT. FROM N. LINE

_____ FT. FROM S. LINE

_____ FT. FROM E. LINE

_____ FT. FROM W. LINE

SW SE SE

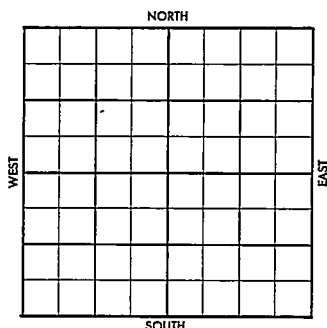

1956

ELEVATION

2514'

REPORT

5-29

RUR

7-11

Comm. 5-27-56

8 5/8" @ 270 w/220

DST 3240-80 op 60 min, rec. 350' SW,
BHP 920/20".DST 5064-5107 op 1 hr, rec. 250' mud,
/ 300' SWDST 5175-85 op 1 hr, gas to Surf, 35mi
rec. 40' GCM, 1340/30"

Cored 5185-91, full rec.

DST 5177-91, failed.

DST 5174-91 pp 90 min, gas to surf. 1 hr
rec. 25' GCM, BHP 2210/30".DST 5194-5229 op 1 hr, rec. 15' SOCM
BHP 200#, FP 50-70

D & A

H. 4295'; L. 4471'; C. 5180'; ###

Miss 5188'

TD 6200'

ABANDONED

County

~~Ford~~

Elev.

Sec.

26

Twp.

28

Rge.

23W

Company

~~Kewanee Oil~~

Farm Name

~~Polson~~

No.

1

TOPS

DEPTH

LOG

DATUM

Loc. in Sec.

Anh.

SW SE SE

Tp.

H.

Tr.

Dg.

BL.

L.

K.C.

B.K.C.

Ce.

C.

M.

M.

K.

Mz.

Mq.

V.

S.

S.

A.

R.

PE.

G.

T.D.

Geol.

Contr.

G-M

Pool

Wildcat

FIRST REPORT
MAY 29 56

Date Comm.

R U R

JUN 2 1956

Co.

Lse.

No.

Sec.

T.

R.

County

~~Hord~~

Elev.

~~514~~

Sec. 26

Twp.

28

Rgs.

23W

Company

Kewanee Oil

Farm Name

Polson

No.

1

TOPS

DEPTH

LOG

DATUM

Loc. in Sec.

Anh.

SW SE SE

Tp.

H.

4295

Tr.

Dg.

BL.

L.

4471

K.C.

B.K.C.

Ce.

C.

5180

M.

K.

Mz.

Me.

V.

S.

S.

A.

R.

Pe.

G.

T.D.

6200

Vernon Hess
Geol.

Contr.

G-M

Pool

Wildcat

ABANDONED

JUL 1 1 1958

0

Date Comm.

R U R

JUN '56

Spd

5-27-56

8 3/4 270 / 220 SX DST 3240 -

80 (60) rec 350' SW BHP 920

(20) Ø3485 JUN 13 '56 Ø 46 43 JUN 20 '56

DST 5064-5107 1hr rec 250' Md +

300' SW BHP? C9 5180 DST 5175

- Ø85 or 1hr gas to 5.35"

ESTM rec 40' GCM 1340/30" crd

5185-91 Full rec Rn9 DST 5177-91

26-28-23W SW SE SE

JAN 27 '56

Failed DST 5174-91 gr

90" gr to ^{MI}surf. 1 hr rec. 25'

GCM BHP 2210/30" DST 5194

-5229 gr 1 hr rec. 15' 50CM

BHP 2001 FP 50-70

JUL 3 '56

Viola 5890 sp 6040

Hib 6141 RTD 6200 Rng Log

JUL 11 '56 X D&A

26-28-23 SW SE SE