


KANSAS Pratt

FORM 51 5M 11-44 PETROL

Section 26 Township 28 Range 12-N

Well No. #3 Megaffin

Company Cities Ser.

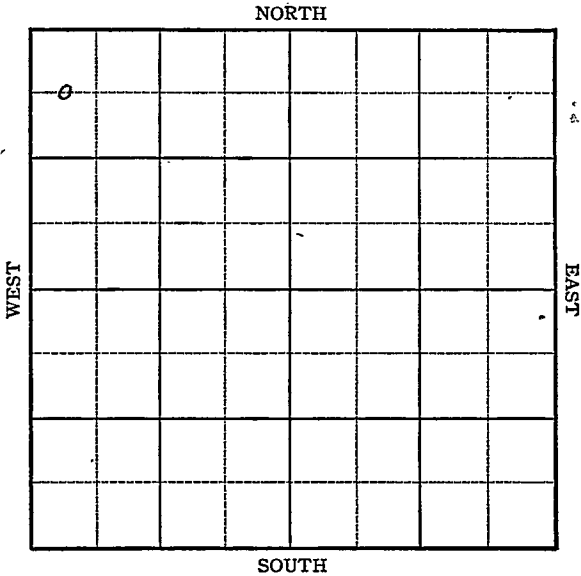

Sec. 26 Twp. 28 R. 12-W

Well No. #3 Megaffin Farm


Cities Service Company

660 Ft. from N. Line

_____ Ft. from S. Line

_____ Ft. from E. Line

330 Ft. from W. Line

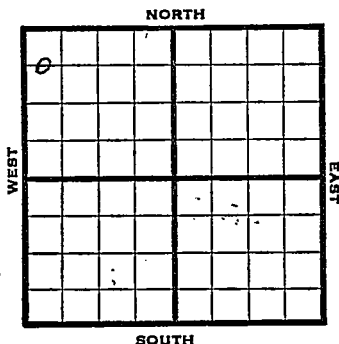

C W L NW NW

REPORT	
1945	Elev. 1860'
12/5	Location
12/12	"
12/20	10" - 349' WOC.
12/29	SD 2775'
1946	
1/10	Lans. 3710' Miss 4159' Viola 4300' Simp 4390' 4400. T.D. 4392' 5" - 4390' RUST.
1/17	Simp 4400' (Corrected) 5" - 4400' T.D. 4417' 3200' fluid.
1/24	Flow 405 oil in 24 hours.
1/30	Simp 4400 5" @ 4400 TD 4417 Bomb 1083 Pot. Grav. 39.0

COMPLETED

KANSASPool Name ChitwoodMap No. K-54 Sec. 26 Twp. 28 R. 12WWell No. 3 MegaffinCities Service CompanyFIRST REPORT Contractor

C WL NW NW

SECTION PLAT

660 Ft. from N. Line Ft. from S. Line Ft. from E. Line330 Ft. from W. Line

0			

Pratt County

Location XRig up

Drilling and Remarks:

RECORD

Cased in., ft.Sand Gas Oil Total Depth

PRODUCTION

1st 24 hrs. Nat. 1st 24 hrs. after shot Gas Cu. Ft.Dry Hole Abandoned

Date

DEC 5 1945 19

S. J. LEWIS Scout

KANSAS

Kansas Pool Name Chitwood

Map No. 54 Sec. 26 Twp. 28 R. 12W

Well No. 3 Megaffin

Cities Service Company

COMPLETED Contractor

E1,1860

SECTION PLAT

C WL NW NW

0			

660 Ft. from N. Line

_____ Ft. from S. Line

_____ Ft. from E. Line

330 Ft. from W. Line

Pratt County

Location _____

Rig up _____

Drilling and Remarks:

Comp 4400

5' C4400

Bond 1083 188

395 Gr

RECORD

Cased _____ in., _____ ft.

Sand _____

Gas _____

Oil _____

Total Depth 4417

PRODUCTION

1st 24 hrs. Nat. _____

1st 24 hrs. after shot _____

Gas _____ Cu. Ft.

Dry Hole _____

Abandoned _____

Date

JAN 30 1946 19

S. J. LEWIS Scout