
FORM 51

Stanton KANSAS

Section 26 Township 28 Range 40W

Well No. #1 Lucas Gas Unit "C"

Company Stanolind

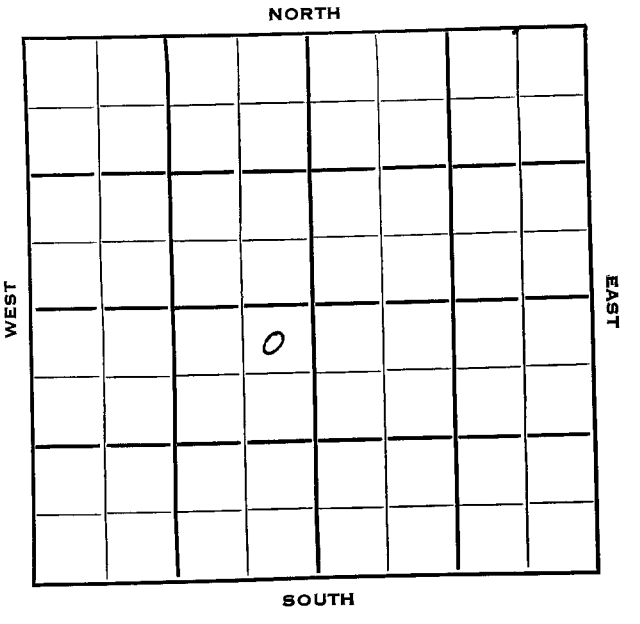

Stanton

KANSAS

SEC.	TWP.	R.
26	28	40W ✓

WELL NO.

#1 Lucas Gas Unit "C"

COMPANY FARM

Stanolind

CONTRACTOR


Hugoton Pool

150 Ft. from N. Line

Ft. from S. Line

150 Ft. from E. Line

Ft. from W. Line

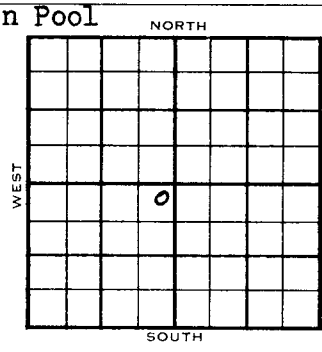

NE NE SW

1954	ELEVATION 3262' RB 3256 IS	REPORT
2/3	Location	
2/10	Drlg 550'	
2/17	8" @ 730' RTD 2402' Schl 5" @ 2380' Her. 2266', Win 2308', Up Ft. 2380'	
2/24	48/ 2266-74 24/ 2280-84 48/ 2289-97 36/ 2316-22 18/ 2327-30 24/ 2340-44 30/ 2350-55 18/ 2358-61 frac.	
3/10	Spud 2-7-54 Gas Well TD 2402' 8" @ 730' Her. 2266', Win 2308', Ft. Riley 2380' TD 2402' 5" @ 2380' 48/ 2266-74 24/ 2280-84 48/ 2289-97 36/ 2316-22 18/ 2327-30 24/ 2340-44 30/ 2350-55 18/ 2358-61 frac. Comp 3,300,000 gas 360#	COMPLETED

X-78

FORM 275 FOR SALE BY KANSAS BLUE PRINT CO.


County Stanton State Kansas

Sec. 26 (Blk. Twp.) 28 (Sur. Rge.) 40W Map No.

Operator Stanolind

Well No. 1 Farm Lucas Gas Unit "C"

Elev. 3262 RB Location NE NE SW

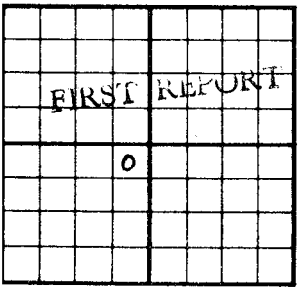

150 Ft. From N Line SW

150 Ft. From E Line Quarter

1st. Report FEB 3 1954

Completion

Remarks

Spudding Date

Drlg. Data Hugoton Pool

Location

J. G. McGHEE

FORM 275 FOR SALE BY KANSAS BLUE PRINT CO.


County Stanton State Kansas

Sec. 26 (Blk. Twp.) 28 (Sur. Rge.) 40W Map No.

Operator Stanolind

Well No. 1 Farm Lucas Gas Unit "C"

Elev. 3256 LS 3262 RB Location NE NE SW

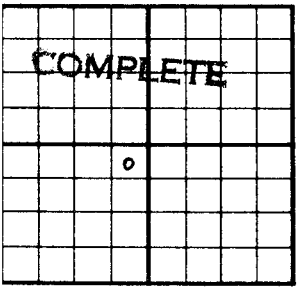

150 Ft. From N Line SW

150 Ft. From E Line Quarter

1st. Report

Completion MAR 10 1954

Remarks Hugoton Pool

Spudding Date 2-7-54

Drlg. Data Gas well TD 2402

8" @ 730 Her. 2266 Win. 2308

Ft. Riley 2360 TD 2402 5" @ 2380

48/ 2266-74 24/ 2280-84 48/ 2289-97

36/ 2316-22 18/ 2327-30 24/ 2340-44

30/ 2350-55 18/ 2358-61 frac

Comm. 3,300,000 gas 360#

J. G. McGEHEE