


KANSAS Grant

FORM 51 5M PETROL

Section 27 Township 28 Range 35W

Well No. 1 Emrie

Company Columbian Fuel

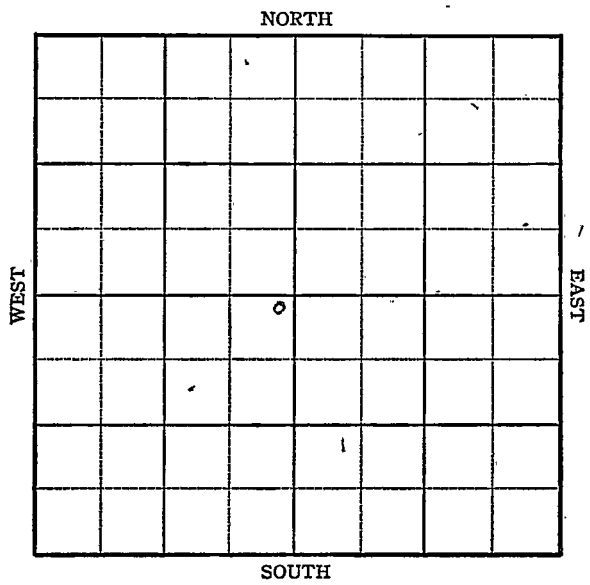

KANSAS Grant

Sec. 27 Twp. 28 R. 35-W

Well No. #1 Emrie Farm

Columbian Fuel Company


100 Ft. from N. Line

 Ft. from S. Line

100 Ft. from E. Line

 Ft. from W. Line

NE SW Elev. 3033

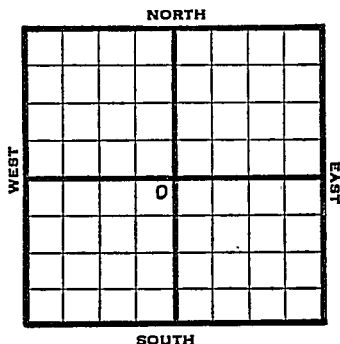

1945

REPORT

9/5

10" @ 565'

Drlg. 2412'

9/12

T 2575

7" @ 2571 RUST

9/19

" " "

9/26

Drlg. 2630' S Gas

10/3

TD 2778

214' of 5" Perf. liner @ 2778

14000 acid.

10 10

" " " " "

10/17

7" @ 2571

214' of 5" Perf. liner @ 2778

14000 acid.

TD 2778

13,645,000 Gas.

419# R Pr.

COMPLETED

KANSASKansas Pool Name HugotonMap No. 27 Sec. 27 Twp. 28 R. 35WWell No. 1 EmrieColumbian Fuel Company**FIRST REPORT**

Contractor

NE SW

SECTION PLAT100 Ft. from N. Line Ft. from S. Line100 Ft. from E. Line Ft. from W. Line

Grant CountyLocation Rig up

Drilling and Remarks:

10"-565
2412**RECORD**Cased in., ft.Sand Gas Oil Total Depth **PRODUCTION**1st 24 hrs. Nat. 1st 24 hrs. after shot Gas Cu. Ft.Dry Hole Abandoned

Date

SEP 5 1945

19

S. J. LEWIS Scout

KANSAS


Kansas

Pool Name HugotonMap No. 27 Sec. 27 Twp. 28 R. 35WWell No. 1 EmrieColumbian Fuel Company

COMPLETED

Contractor

NE SW

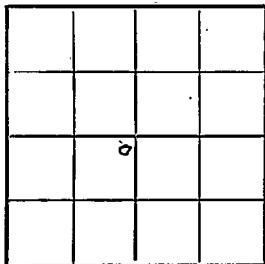E 13033
SECTION PLAT100 Ft. from N. Line Ft. from S. Line100 Ft. from E. Line Ft. from W. LineGrant CountyLocation Rig up

Drilling and Remarks:

7" @ 2571214' of 5" Perf liner@ 2778.14000 acid13,645,000 gal415# R₂H₂

RECORD

Cased in. ft.Sand Gas Oil Total Depth 2778.

PRODUCTION

1st 24 hrs. Nat. 1st 24 hrs. after shot Gas Cu. Ft.Dry Hole Abandoned

Date

OCT 1 7 1945 19S. J. LEWIS

Scout