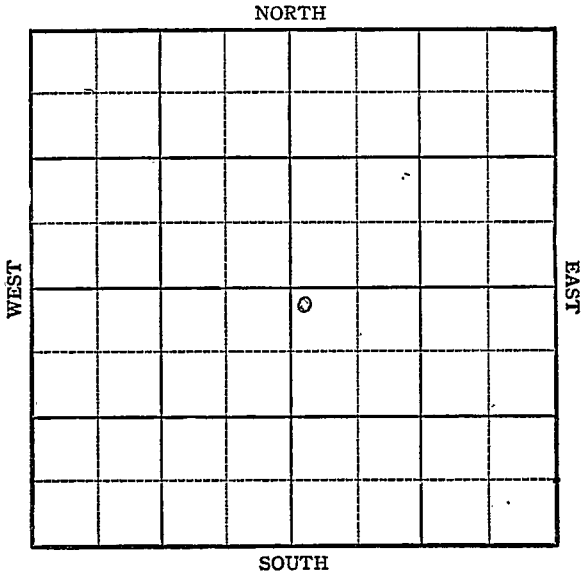


KANSAS

FORM 51 5M BRIX

Section 27 Township 28 Range 33WWell No. #2 #1 TrimpaCompany Helmerick & Payne

Sec. 27 Twp. 28 R. 33W
 Well No. #2 Trimpa Farm
Helmrick & Payne Company
Hugoton


100 Ft. from N. Line

 Ft. from S. Line

 Ft. from E. Line

100 Ft. from W. Line

NW SE

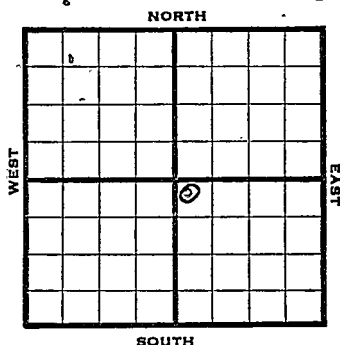

1945 Elev. 2961 R E P O R T

1/24 Location

1/31 RUR

2/7 "

2/14 "

2/21 10" @ 773

Drlg 2174

2/28 5" @ 2786

TD 2790 RUST

3/7 " " "

3/14 " " "

3/23 " " "

3/29 21 shots 2686-2700

13 shots 2713-2736

28 shots 2737-2757 7500acid.

Water squeeze

3/5 PB 2758 8000 acid.

4/22 1000 acid.

4/20 4 Rips 2686-2700.

4/27 " " " "

5/3 " " " "

5/10 " " " "

5/17 " " " "

5/24 " " " "

5/31 Drlg " "

6/8 " " " "

OVER

1945

6/14 4 Rips 2686-2700

7/3 5" @ 2786
27500 acid.
TD 2790'
5,430,000 Gas.
432# R PR.

COMPLETED

Pool Name HugotonMap No. NM Sec. 27 Twp. 28 R. 33WWell No. 1 TrimpaHelmerick & Payne CompanyFIRST REPORT Contractor

NW SE

SECTION PLAT

100 Ft. from N. Line Ft. from S. Line Ft. from E. Line100 Ft. from W. Line

		o	

Haske 11Location 8Rig up

Drilling and Remarks:

RECORD

Cased in., ft.Sand Gas Oil Total Depth

PRODUCTION

1st 24 hrs. Nat. 1st 24 hrs. after shot Gas Cu. Ft.Dry Hole Abandoned

Date

JAN 24 1945 19S. J. LEWIS

Scout

no wall map

Misc. Small Maps	LR
Cards	DF
Tracing	
France Map	LR
Scottish Map	
Moody Map	
Geological Map	
Moody Plat Book	

Pool Name HugotonMap No. N/14 Sec. 27 Twp. 28 R. 33WWell No. 2 TrimpaHelmerick & Payne Company**CORRECTION**

Contractor

NW SE

SECTION PLAT100 Ft. from N. Line Ft. from S. Line Ft. from E. Line100 Ft. from W. Line

		o	

Haskell County

Location Rig up

Drilling and Remarks:

Reported in
#1 Trimpa**RECORD**Cased in., ft.Sand Gas Oil Total Depth **PRODUCTION**1st 24 hrs. Nat. 1st 24 hrs. after shot Gas Cu. Ft.Dry Hole Abandoned

Date

JAN 31 1945

19

S. J. LEWIS

Scout

no wall maps

Small Mapss	LC
Car's	Perry
Tracing	
France Map	
Scarborough Map	LC
Pierce Map	
Geological Dept.	
Pierce Plat Book	

KANSAS

Kansas Pool Name HugotonMap No. no map Sec. 27 Twp. 28 R. 33WWell No. 2 TrimpaHelmerick & Payne

Company

COMPLETED

Contractor

NW SE

E12961
SECTION PLAT100 Ft. from N. Line Ft. from S. Line Ft. from E. Line100 Ft. from W. Line

Haskell CountyLocation Rig up

Drilling and Remarks:

5" @ 278627500 acid5,430,000 Gas432 # R/P**RECORD**Cased in., ft.Sand Gas Oil Total Depth 2780**PRODUCTION**1st 24 hrs. Nat. 1st 24 hrs. after shot Gas Cu. Ft.Dry Hole Abandoned

Date

JUL 3 1945S. J. LEWIS Scout

12 MAY 1964

no wall

Misc. Small Maps	<u>14</u>
Cards	<u>15</u>
Tracing	
France Map	<u>X</u>
Scarborough Map	<u>X</u>
Pierce Map	
Geological Dept.	
Pierre Point Dept.	