


KANSAS Pratt County

Section 27 Township 28 Range 12W

Well No. #1 Chitwood "B"

Company Lion Oil Ref.

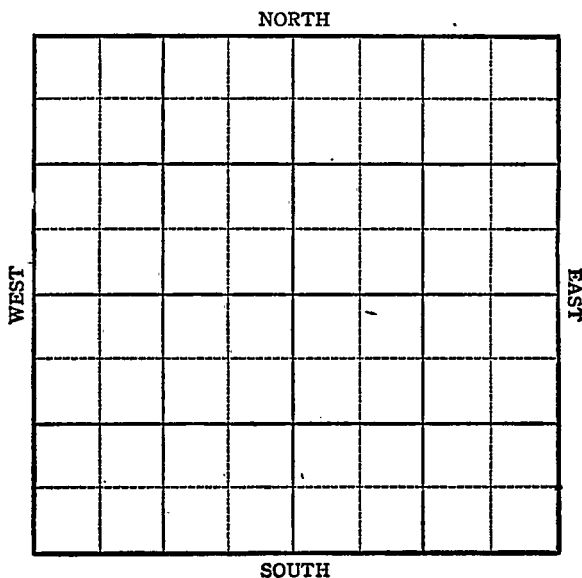

KANSAS Pratt County

Sec. 27 Twp. 28 R. 12W

Well No. #1 Chitwood "B" Farm

Lion Oil Ref. Company


Chitwood

330 Ft. from N. Line

 Ft. from S. Line

 Ft. from E. Line

990 Ft. from W. Line

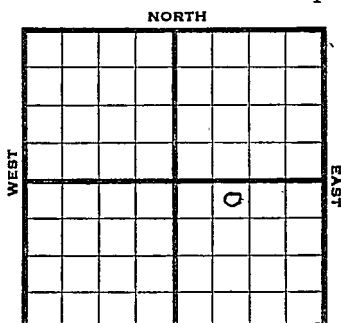

NE NW SE Eden 1874

1944

REPORT

11/15 Location

11/24 Derrick

11/29 Surface Hole

12/6 Plug 4394'
84 shots 4300-4314
Flow 108 oil in 18 hrs.

12/14 Drlg. 3000'

12/21 Miss. 4194
Kand. 4258
Viola 4336
Simp 4435
TD 4437

12/29 Run csg.
5" @ 4435' RUST

1945

1/3 " " " "

1/10 Flow 100 oil in 7 hrs
1000 acid Flow 20 oil PH

1/17 Flow 18 oil PH 12 hrs
35 shots 4340-52 1000 acid 9 M gas

1/26 " " " " " " " "

1/31 PB 4420'

2/7 " "

2/14 " "

2/21 " "

OVER


1945
2/28 PB 4420
3/7 " "
3/14 " "
3/23 " "
3/29 " "
4/5 " "
4/11 Simp 4435
5" @ 4435 2000 acid.
TD 4437
Pump 115 oil plus 20% wtr. Pot.
Grav. 40.9

COMPLETED

Pool Name ChitwoodMap No. 54 Sec. 27 Twp. 28 R. 12WWell No. 1 Chitwood "B"Lion Oil Ref. CompanyFIRST REPORT Contractor

NE NW SE

SECTION PLAT

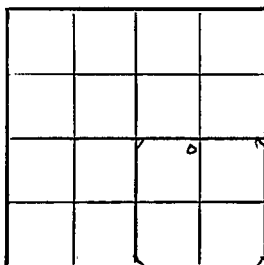330 Ft. from N. Line Ft. from S. Line Ft. from E. Line990 Ft. from W. LinePrattLocation XRig up

Drilling and Remarks:

Not file

RECORD

Cased in., ft.Sand Gas Oil Total Depth

PRODUCTION

1st 24 hrs. Nat. 1st 24 hrs. after shot Gas Cu. Ft.Dry Hole Abandoned

Date

NOV 15 1941

19

S. J. LEWIS

Scout

Misc. Small Maps

Cards

Tracing

France Map

Scarborough Map

Moody Map


dy Plat Book

Leid

Leid

Kansas

Pool Name ChitwoodMap No. 54 Sec. 27 Twp. 28 R. 12WWell No. 1 Chitwood "B"

Lion Oil Ref. _____ Company

COMPLETE


Contractor _____

NE NW SE

SECTION PLAT330 Ft. from N. Line

_____ Ft. from S. Line

_____ Ft. from E. Line

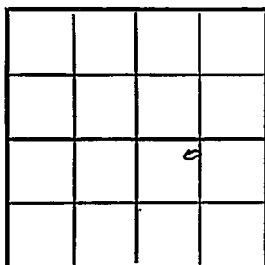990 Ft. from W. Line

Pratt

Location _____

Rig up _____

Drilling and Remarks:

*Swing 4435**5-4435**2000 acid**Pump 115 oil + 20%**Water Pox**40 E G***RECORD**

Cased _____ in. _____ ft.

Sand _____

Gas _____

Oil _____

Total Depth 4432**PRODUCTION**

1st 24 hrs. Nat. _____

1st 24 hrs. after shot _____

Gas _____ Cu. Ft.

Dry Hole _____

Abandoned _____

Date

APR 11 1945

19

S. I. LEWIS

Scout

Misc. Small Maps

Cards

Tracing

France Map

Scarborough Map

Moody Map

Geological Dept.

Moody Plat Book