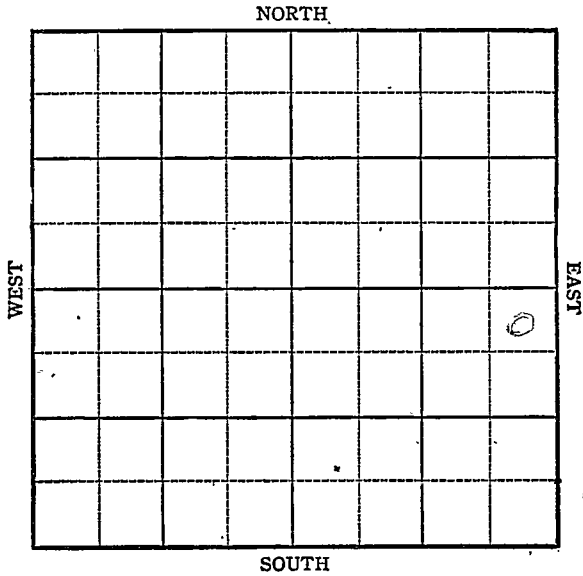



Section 27 Township 28 Range 12WWell No. #2 Chitwood "B"Company Lion Oil Ref.

KANSAS

Pratt County

Sec. 27 Twp. 28S R. 12WWell No. #2, Chitwood "B" FarmLion Oil Ref. Company

Chitwood

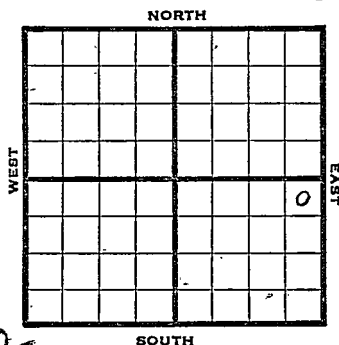330 Ft. from N. Line Ft. from S. Line330 Ft. from E. Line Ft. from W. LineNE SE *Elev. 1862*

1945

R E P O R T

1-10	Location
1/17	Drlg 1400
1/26	Drlg. 3200'
1/31	8" @ 318
	Viola 4326
	Drlg. 4340'
2/7	Simp sd 4426
	TD 4427
	5" @ 4426 RUST
2/14	" " " "
2/21	23 shots 4322-40
	1000 acid 9,300,000 gas
2/28	" " " " "
3/7	" " " " "
3/14	" " " " "
3/23	" " " " "
3/29	" " " " "
4/5	" " " " "
4/11	Simp Sd 4424
	5" @ 4424 1000 acid.
	TD 4427
	Pump 32 oil plus 50% wtr Pot.
	Grav. 40.9

COMPLETED

Pool Name ChitwoodMap No. 54 Sec. 27 Twp 28 R. 12WWell No. 2 Chitwood "B"Lion Oil Ref.

Company

FIRST REPORT

Contractor

NE SE

SECTION PLAT

			o

330 Ft. from N. Line

Ft. from S. Line

330 Ft. from E. Line

Ft. from W. Line

PrattLocation X

Rig up

Drilling and Remarks:

*Hot gill
17m NE M&PC*

RECORD

Cased _____ in., _____ ft.

Sand _____

Gas _____

Oil _____

Total Depth _____

PRODUCTION

1st 24 hrs. Nat. _____

1st 24 hrs. after shot _____

Gas _____ Cu. Ft.

Dry Hole _____

Abandoned _____

Date

JAN 10 1945

19

S. J. LEWIS

Scout

Misc. Small Maps	<i>LR</i>
Cards	<i>Little</i>
Tracing	<i>LR</i>
France Map	<i>L</i>
Scarborough Map	<i>LR</i>
Pierce Map	<i>L</i>
Geological Dept.	
Pierce Plat Book	

Kansas

Pool Name ChitwoodMap No. 54 Sec. 27 Twp. 28 R. 12WWell No. 2 Chitwood "B"

Lion Oil Ref.

Company

COMPLETED

Contractor

NE SE


SECTION PLAT

330 Ft. from N. Line

Ft. from S. Line

330 Ft. from E. Line

Ft. from W. Line

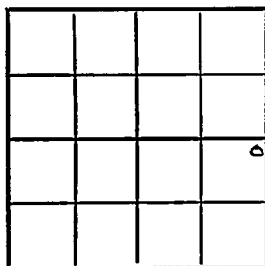

Pratt

Location

Rig up

Drilling and Remarks:

*Comp. Sol 4424**5" @ 4424**1000 acid**Pump 32 oil +**50% Water Pst**40 E 1/4*

RECORD

Cased _____ in., _____ ft.

Sand _____

Gas _____

Oil _____

Total Depth 4427

PRODUCTION

1st 24 hrs. Nat. _____

1st 24 hrs. after shot _____

Gas _____ Cu. Ft.

Dry Hole _____

Abandoned _____

Date

APR 1 1 1945 19

S. J. LEWIS

Scout

Misc. Small Maps

Cards

Tracing

France Map

Scarborough Map

Moody Map

Geological Dept.

Moody Plat Book