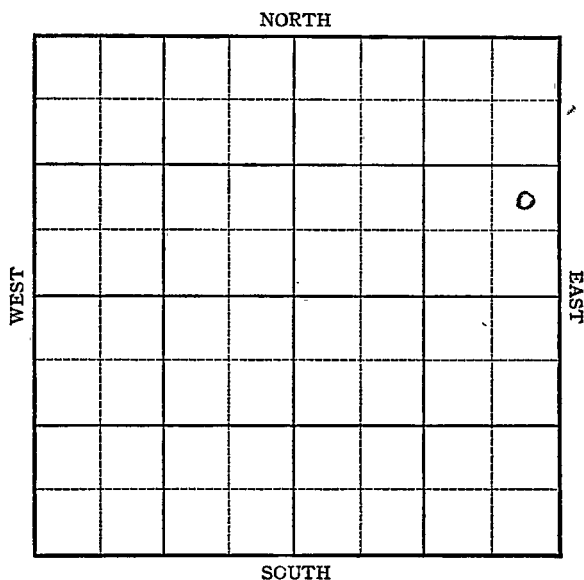


KANSAS

Pratt

Section 27 Township 28 Range 12WWell No. #4 EvansCompany Gulf

KANSAS

Pratt

Sec. 27 Twp. 28 R. 12W

Well No. #4 Evans Farm

Gulf Company


Chitwood

 Ft. from N. Line

990 Ft. from S. Line

330 Ft. from E. Line

 Ft. from W. Line

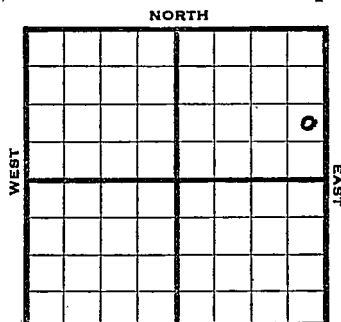

NE SE NE Elev. 1865 SOUTH

1945

R E P O R T

2/28 Location
3/7 10" @ 410
Drlg 1835
3/14 Drlg 3545
3/23 Drlg. 4318
3/29 Viola 4322
Simp 4417
TD 4461
5" @ 4460' RUST
4/5 42 shots 4417-4425 1000 acid.
Flow 44 oil per hr 11 hrs.
4/12 " " " " " "
4-18 Simp 4417'
5" at 4460'
42 shots 4417-25'
1000 acid
Bomb pot 2565 oil plus 10% water pot
Gravity 40.9
Total Depth 4461'

COMPLETED

Pool Name ChitwoodMap No. 54 Sec. 27 Twp. 28 R. 12WWell No. 4 EvansGulf Company

FIRST REPORT Contractor

NE SE NE

SECTION PLAT

			o

 Ft. from N. Line990 Ft. from S. Line330 Ft. from E. Line Ft. from W. LinePrattLocation XRig up

Drilling and Remarks:

Hot 7 in

RECORD

Cased in., ft.Sand Gas Oil Total Depth

PRODUCTION

1st 24 hrs. Nat. 1st 24 hrs. after shot Gas Cu. Ft.Dry Hole Abandoned

Date

FEB 28 1945

19

S. J. LEWIS

Scout

Kansas Pool Name ChitwoodMap No. 54 Sec. 27 Twp. 28 R. 12WWell No. 4 EvansGulf CompanyCOMPLETE Contractor

NE SE NE

E 1, 1865
SECTION PLAT Ft. from N. Line990 Ft. from S. Line330 Ft. from E. Line Ft. from W. Line

			2

Prett

Location Rig up

Drilling and Remarks:

Shut 4417
5104460
425 to 4417-25
1000 Seal
Born 4417-25 oil
710/10 Water Pat
40 1/2 cu

RECORD

Cased in., ft.Sand Gas Oil Total Depth 4461

PRODUCTION

1st 24 hrs. Nat. 1st 24 hrs. after shot Gas Cu. Ft.Dry Hole Abandoned

Date

APR 13 1945

19

S. J. LEWIS

Scout