


Section 27 Township 28 Range 13-WWell No. #1 ThompsonCompany Harber Drlg. etal

NORTH

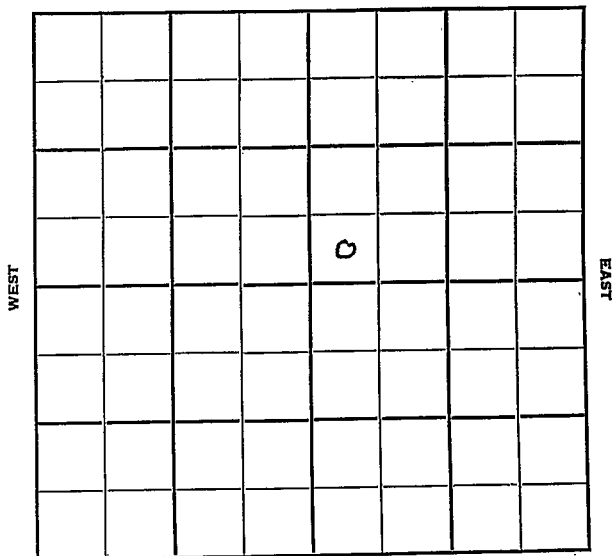

SOUTH

Sec. 27 Twp. 28 R. 13W

Well No. #1 Thompson Farm

Harbar Drlg. Company

Harbar Drlg. - Contr. Contractor

Wildcat


 Ft. from N. Line

330' Ft. from S. Line

 Ft. from E. Line

330' Ft. from W. Line

SW SW NE

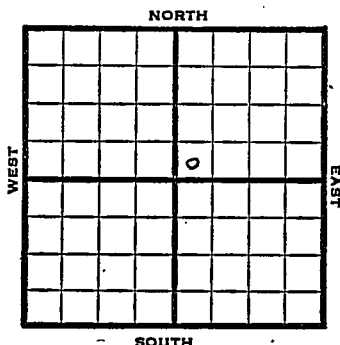

1950 Elev 1936' REPORT

11/1 MIM
12/6 Spud 11-10-50
10" @ 375
Lans 3858 Miss 4301
Kinderhook 4319 Viola 4349
SO 4381-89
DST 4361-95 Rec 45' mud 150' gcm
Simp 4413 Sand 4459
DST 4459-79 opn 45 min rec 3220' SW
Arb 4560
TD 4619
D&A
ABANDONED

County **Pratt** State **Kansas**

Sec. 27 (Blk. Twp.) 28 (Sur. Rge.) 13W Map No.

Operator Harbar Drig. etal.

Well No. 1 - Farm Thompson

Elev.		Location	SW	SW	NE
-------	---	----------	----	----	----

330 Ft. From S Line. NE

330	Ft. From W	Line	Quarter
-----	------------	------	---------

1st. Report : NOV 1 1950

Completion _____

Remarks British-Am. DFM

Harbar Drig. - Contr.

Spudding Date _____

Drlg. Data ~~WCPD 5/2 Sec 22~~ Wildcat

III

J. E. TYRA

J. E. TYRA