

Map No. KANSAS Sec. 28 Twp. 28 R. 33W
 Well No. 1-~~Lasswell~~ TRIMPA Farm
Helmreich & Payne et al Company

NORTH

WEST

EAST

SOUTH

Location _____
 Drilling Remarks _____

Rig Up _____
 Drilling Remarks _____

RECORD

Cased _____ in. _____ ft.
 Sand _____
 Gas _____
 Oil _____
 Total Depth _____

PRODUCTION

1st 24 hrs. Nat. _____
 1st 24 hrs. after shot _____
 Gas _____ cu. ft. _____
 Dry Hole _____
 Abandoned _____

Haskell

Map No. KANSAS Sec. 28 Twp. 28 R. 33W


Well No. 1- ~~Larson~~ Grimes Farm
Helmerich & Payne etc. Company

1320 Ft. from N. Line

_____ Ft. from S. Line

1320 Ft. from E. Line

_____ Ft. from W. Line

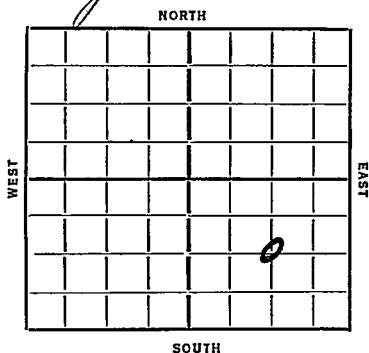

REPORT

1/29 Location

2/7 Rig

2/14 2/21-2/28-3/6-

3/13 --

3/20 --

3/27 --4/2--4/10-- 4/16--4/23--4/30--

5/7 --5/14--5/21--5/28--6/4--6/11--

6/18 --6/25--

7/2 --

7/9 No report.

7/16 583'. N.R.

7/23 Shut down.

7/30 7" @ 2653'. Rigging up standard tools.

8/6 No report.

8/13 --8/20--8/27-- 9/3-- 9/10--9/18--

9/24 --10/1--10/8--10/15--

10/21 1/36-Sand 2653'. TD 2978'.

P.B. 2971'.

Shot 70 qts. 3 million gas.

COMPLETED

KANSAS

Map No. No Map Sec. 28 Twp. 28 R. 33WWell No. 1-LarsonHelmerick & Payne et al Company

Contractor

FIRST REPORTS


SECTION PLAT

1320 Ft. from N. Line

Ft. from S. Line

1320 Ft. from E. Line

Ft. from W. Line

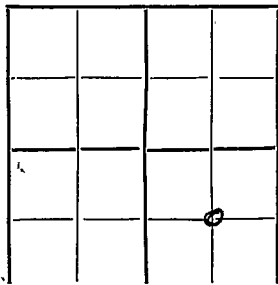Location ✓

Rig up

Drilling and Remarks:

RECORD

Cased in ft.

Sand

Gas

Oil

Total Depth

PRODUCTION

1st 24 hrs. Nat.

1st 24 hrs. after shot

Gas Cu. Ft.

Dry Hole

Abandoned

Date

ORVAL MANNSCHRECK

129-36 192

Scout

KANSAS

Map No. *No Map* Sec. *28* Twp. *28* R. *33W*

Well No. *1 - Trimpa*

Helmreich & Payne, et al Company

Contractor

CORRECTION

1320 Ft. from N. Line


Ft. from S. Line

1320 Ft. from E. Line

Ft. from W. Line

CORRECTION

SECTION PLAT

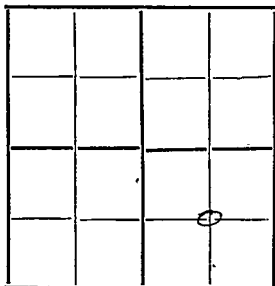

RECORD

Location.....

Cased.....in.,ft.

Rig up.....

Sand.....

Drilling and Remarks:

Gas.....

Oil.....

Total Depth.....

incorrectly reported as #1 - Larson

PRODUCTION

1st 24 hrs. Nat.....

1st 24 hrs. after shot.....

Gas.....Cu. Ft.

Dry Hole.....

Abandoned.....

Date

MAR 11 1936

192

W. H. H.

Scout

Map No. 28 Sec. 28 Twp. 28 R. 33W

Well No. Thompson

Ne Landrick & Payne & Co Company

Contractor

SECTION PLAT

1320 Ft. from N. Line

_____ Ft. from S. Line

1320 Ft. from E. Line

_____ Ft. from W. Line

COMPLETED

Location _____

Rig up _____

Drilling and Remarks:

Sand 2653
P.B. 2971
Drill 709 to
3 M Gas

RECORD

Cased _____ in., _____ ft.

Sand _____

Gas _____

Oil _____

Total Depth 2978

PRODUCTION

1st 24 hrs. Nat. _____

1st 24 hrs. after shot _____

Gas _____ Cu. Ft.

Dry Hole _____

Abandoned _____

Date

OCT 21 1936 19

S. J. LEWIS Scout