KANSAS


Kingman

SECTION 29 TOWNSHIP 28S RANGE 5W

WELL NO. #1 Beck

COMPANY Lario O&G

NORTH SW SW NE

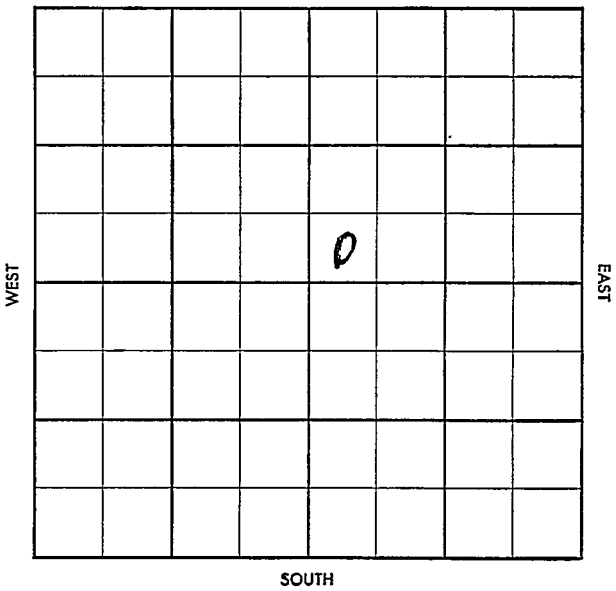

FORM 504-3 SUNRAY

S-513-A

CO. Kingman ELEV.

SEC. 29 TWP. 28 RGE. 5W

COMPANY Lario O & G NO. 1

OCT 9 '57

FIRST REPORT

FARM Beck

LOC. SW SW NE

GEOL.

CONTR. Sterling

POOL Bollinger

SPUD 10-7-57

8" @ 258/ WOC

CO. LSE. NO. SEC. TWP. RGE.

5-513-A

CO. Kingman ELEV. 1439 0

SEC. 29 TWP. 28 RGE. 5W

COMPANY Lario O & G NO. 1

COMPLETE

DEC 26 '57

FARM Beck

LOC. SW SW NE

CO. LSE. NO. SEC. TWP. RGE.

46 2789
10 tan 3025
L 3115
kc 3271
Chat 3883
Mdl 3900
BKC
Mor 3594
Ce 3703
TD 3905

GEOL.

CONTR. Sterling

POOL Bollinger

SPUD 10-7-57

8" @ 258/ WOC

DST 3685 OCT 25 ''

DST 3885 -93
60" G/4" rec
72' GCM BHP
1463/30" 833/30"

FP 33-48

DST 3886
3905 2hrs G/20" ga est
mw to 40 mcf rec 1260'
U Cassy O 360' Muddy Fm
O FP 127-525
BHP 1463-1307/30"
no log 5½" 3901
CO 3904 PBTD 76 BOph +
10% w Gr 34.6° TR Pop

NOV 6 '57

NOV 20 '57 NOV 27 '57 P 79 BO + 69 ow
24 hr P 88 BO 69 ow 24 hrs
JAN 4 '58 P 75 BOPD + 69 ow
DEC - DEC 26 '57 P Hy 58 BOPD
+ 69 ow Gr 37°

Miss