

KANSAS


Haskell

FORM 51 5M BR1X

Section 29 Township 28 Range 33W

Well No. ~~#3~~ H. Groth

Company Helerick & Payne

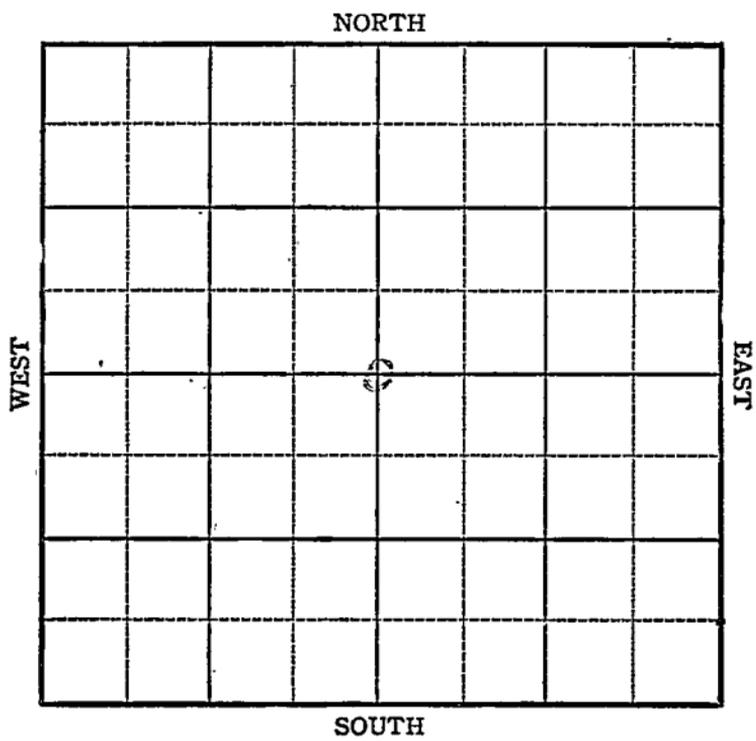

Sec. 29 Twp. 28 R. 33W

Well No. #3 ~~#12~~ Groth Farm

Helmerick & Payne Company

Hugoton


2640 Ft. from N. Line

_____ Ft. from S. Line

2640 Ft. from E. Line

_____ Ft. from W. Line

C Sec. _____ Elev. 2967

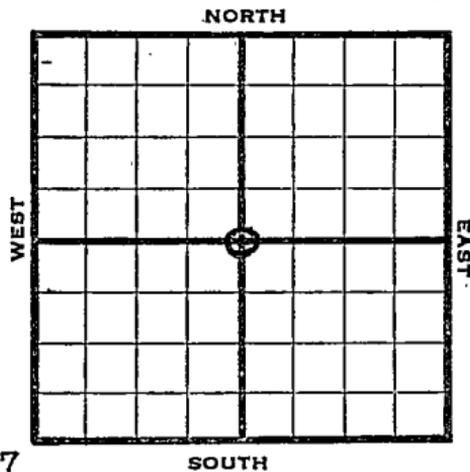

1945

R E P O R T

2/7	720 run csg
2/14	10" @ 726 Drlg 2775
2/21	5" @ 2826 TD 2830
2/28	TD 2832 HFW Squeeze off
3/7	TD 2834 PB 2800
3/14	9000 acid
3/23	" "
3/29	HFW Squeeze
4/5	25000 acid.
4/22	" "
4/20	" "
4/27	" "
5/3	" "
5/10	" "
5/17	" "
5/24	" "
5/31	" "
6/8	" "
6/14	" "
7/3	5" @ 2826 TD 2834 25000 acid. 7,730,000 Gas

COMPLETED

Pool Name HugotonMap No. MM Sec. 29 Twp. 28 R. 33WWell No. 1 GrothHelmerick & Payne Company

FIRST REPORT

Contractor

C Sec


SECTION PLAT

2640 Ft. from N. Line

_____ Ft. from S. Line

2640 Ft. from E. Line

_____ Ft. from W. Line

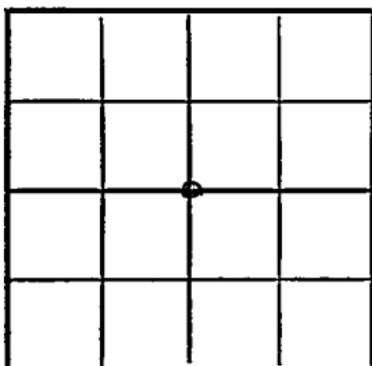

Haskell

Location _____

Rig up _____

Drilling and Remarks:

720 run csg.

RECORD

Cased _____ in., _____ ft.

Sand _____

Gas _____

Oil _____

Total Depth _____

PRODUCTION

1st 24 hrs. Nat. _____

1st 24 hrs. after shot _____

Gas _____ Cu. Ft.

Dry Hole _____

Abandoned _____

Date

FEB 7 1945 19S. I. LEWIS Scout

Pool Name HugotonMap No. W/M Sec. 29 Twp. 28 R. 33WWell No. 3 H. GrothHelmerick & Payne CompanyCORRECTION Contractor

C sec.


SECTION PLAT

2640 Ft. from N. Line

_____ Ft. from S. Line

2640 Ft. from E. Line

_____ Ft. from W. Line

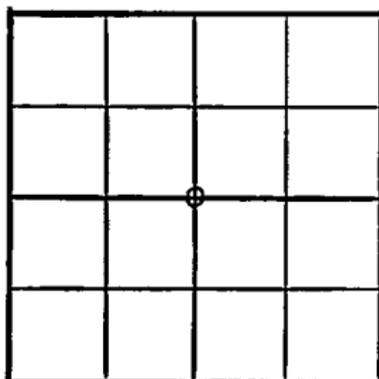

Haskell

Location _____

Rig up _____

Drilling and Remarks:

reported as
#1 Groth

RECORD

Cased _____ in., _____ ft.

Sand _____

Gas _____

Oil _____

Total Depth _____

PRODUCTION

1st 24 hrs. Nat. _____

1st 24 hrs. after shot _____

Gas _____ Cu. Ft.

Dry Hole _____

Abandoned _____

Date

FEB 28 1945 19

S. J. LEWIS Scout

KANSAS

Kansas Pool Name HugotonMap No. MS map Sec. 29 Twp. 28 R. 33WWell No. 3 H. GrothHelmerick & Payne Company**COMPLETED**

Contractor


C Sec.

E 12767
SECTION PLAT2640 Ft. from N. Line

_____ Ft. from S. Line

2640 Ft. from E. Line

_____ Ft. from W. Line

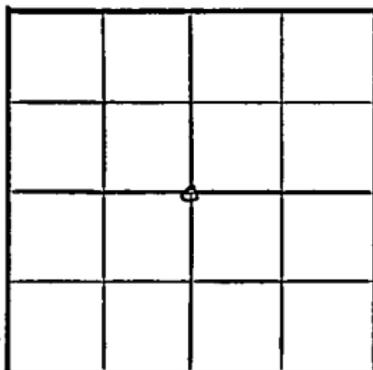Haskell County

Location _____

Rig up _____

Drilling and Remarks:

5" @ 2826250000 acid7,730,000 Gas

RECORD

Cased in. ft.

Sand _____

Gas _____

Oil _____

Total Depth 2834

PRODUCTION

1st 24 hrs. Nat. _____

1st 24 hrs. after shot _____

Gas _____ Cu. Ft.

Dry Hole _____

Abandoned _____

Date

JUL 3 1945 19S. J. LEWIS Scout