
FORM 51 10M 8-47

Haskell County KANSAS

Section 29 Township 28 Range 34W

Well No. 1 Winstead

Company United Prod.

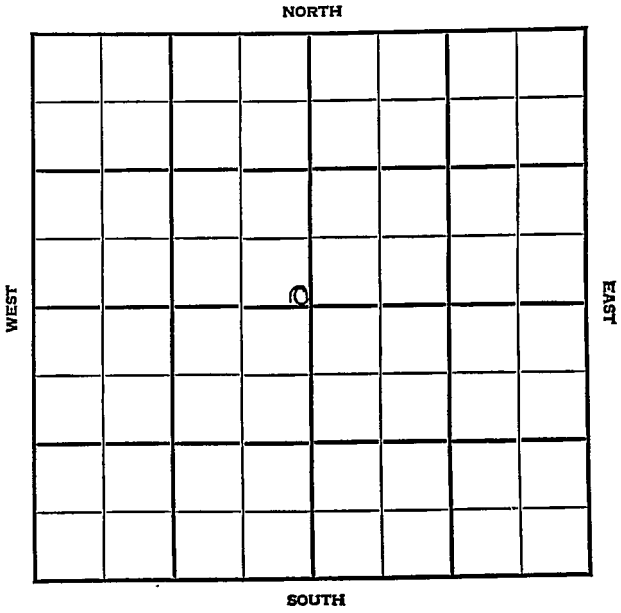

FORM 252-A
5M 9-47 PETROL

Haskell KANSAS

Sec. 29 Twp. 28 R. 34W

Well No. #1 Winstead Farm

United Prod. Company

Hugoton


____ Ft. from N. Line

100 Ft. from S. Line

100 Ft. from E. Line

____ Ft. from W. Line

SE NW

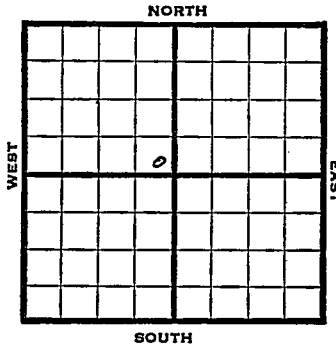

1947	Elev. 3023' REPORT
12/17	Location
12/30	"
1948	
1/7	10" @ 653' Drlg. 1,300'
1/14	TD 2590' 7"@ 2584'
1/21	TD 2770'
1/26	2000 acid
2/4	10000 acid.
2/11	"
2/18	"
2/25	7" @ 2584' 230' of 5" perf. liner @ 2770' 12,000 acid. 11,300,000 Gas. 423# R. Pr. TD 2770' Comp.

COMPLETED

Form 26 200 Bks. 10-46 Petrol

Kansas

Hugoton Pool

Map No. _____ Sec. 29 Twp. 28 R. 34W


Well No. 1 Winstead

United Prod. Company

FIRST REPORT Contractor

SE NW

SECTION PLAT

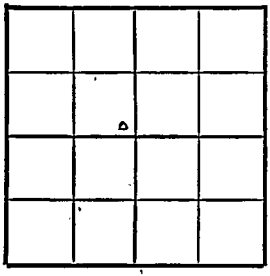

_____ Ft. from N. Line

100 Ft. from S. Line

100 Ft. from E. Line

_____ Ft. from W. Line

Haskell County

Location X

Rig up _____

Drilling and Remarks:

RECORD

Cased _____ in., _____ ft.

Sand _____

Gas _____

Oil _____

Total Depth _____

PRODUCTION

1st 24 hrs. Nat. _____

1st 24 hrs. after shot _____

Gas _____ Cu. Ft.

Dry Hole _____

Abandoned _____

Date

DEC 17 1947 19 S. J. LEWIS Scout

Form 26—200 Bks.—1-48—Palace

Hugoton Pool

Kansas

No Map

Map No. _____ Sec. 29 Twp. 28 R. 34W

Well No. 1 Winstead

United Prod. Company


COMPLETE

Contractor

SE NW

E/ 3023

SECTION PLAT

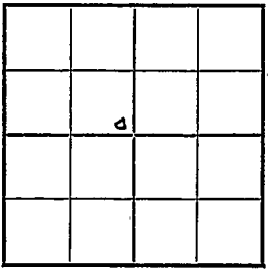

_____ Ft. from N. Line

100 Ft. from S. Line

100 Ft. from E. Line

_____ Ft. from W. Line

Haskell County

Location _____

Rig up _____

Drilling and Remarks:

7" @ 2384

280' of 5" liner @ 2770

1200 and 11,300,000 Gas.

423 MCF

RECORD

Cased _____ in., _____ ft.

Sand _____

Gas _____

Oil _____

Total Depth 2770

PRODUCTION

1st 24 hrs. Nat. _____

1st 24 hrs. after shot _____

Gas _____ Cu. Ft.

Dry Hole _____

Abandoned _____

Date

FEB 25 1948 19____

S. J. LEWIS Scout